


# T. 4S. R. 10W. W.M.

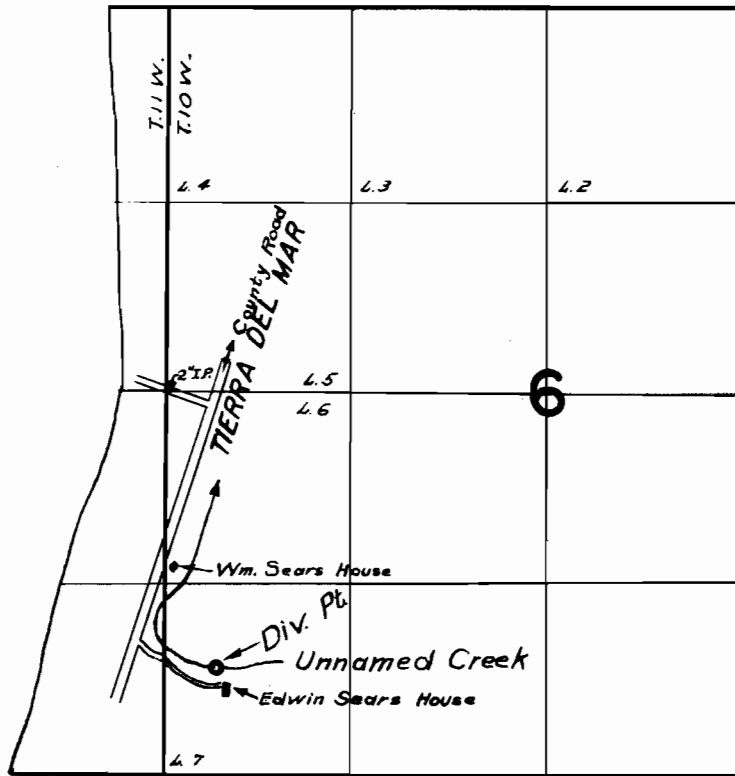


## FINAL PROOF SURVEY UNDER

Transfer No. S-161 For EDWIN G. SEARS

Application No. 39262 Permit No. 29245  
IN NAME OF

WILLIAM G. SEARS

Surveyed May 14 1965, by M. Bish

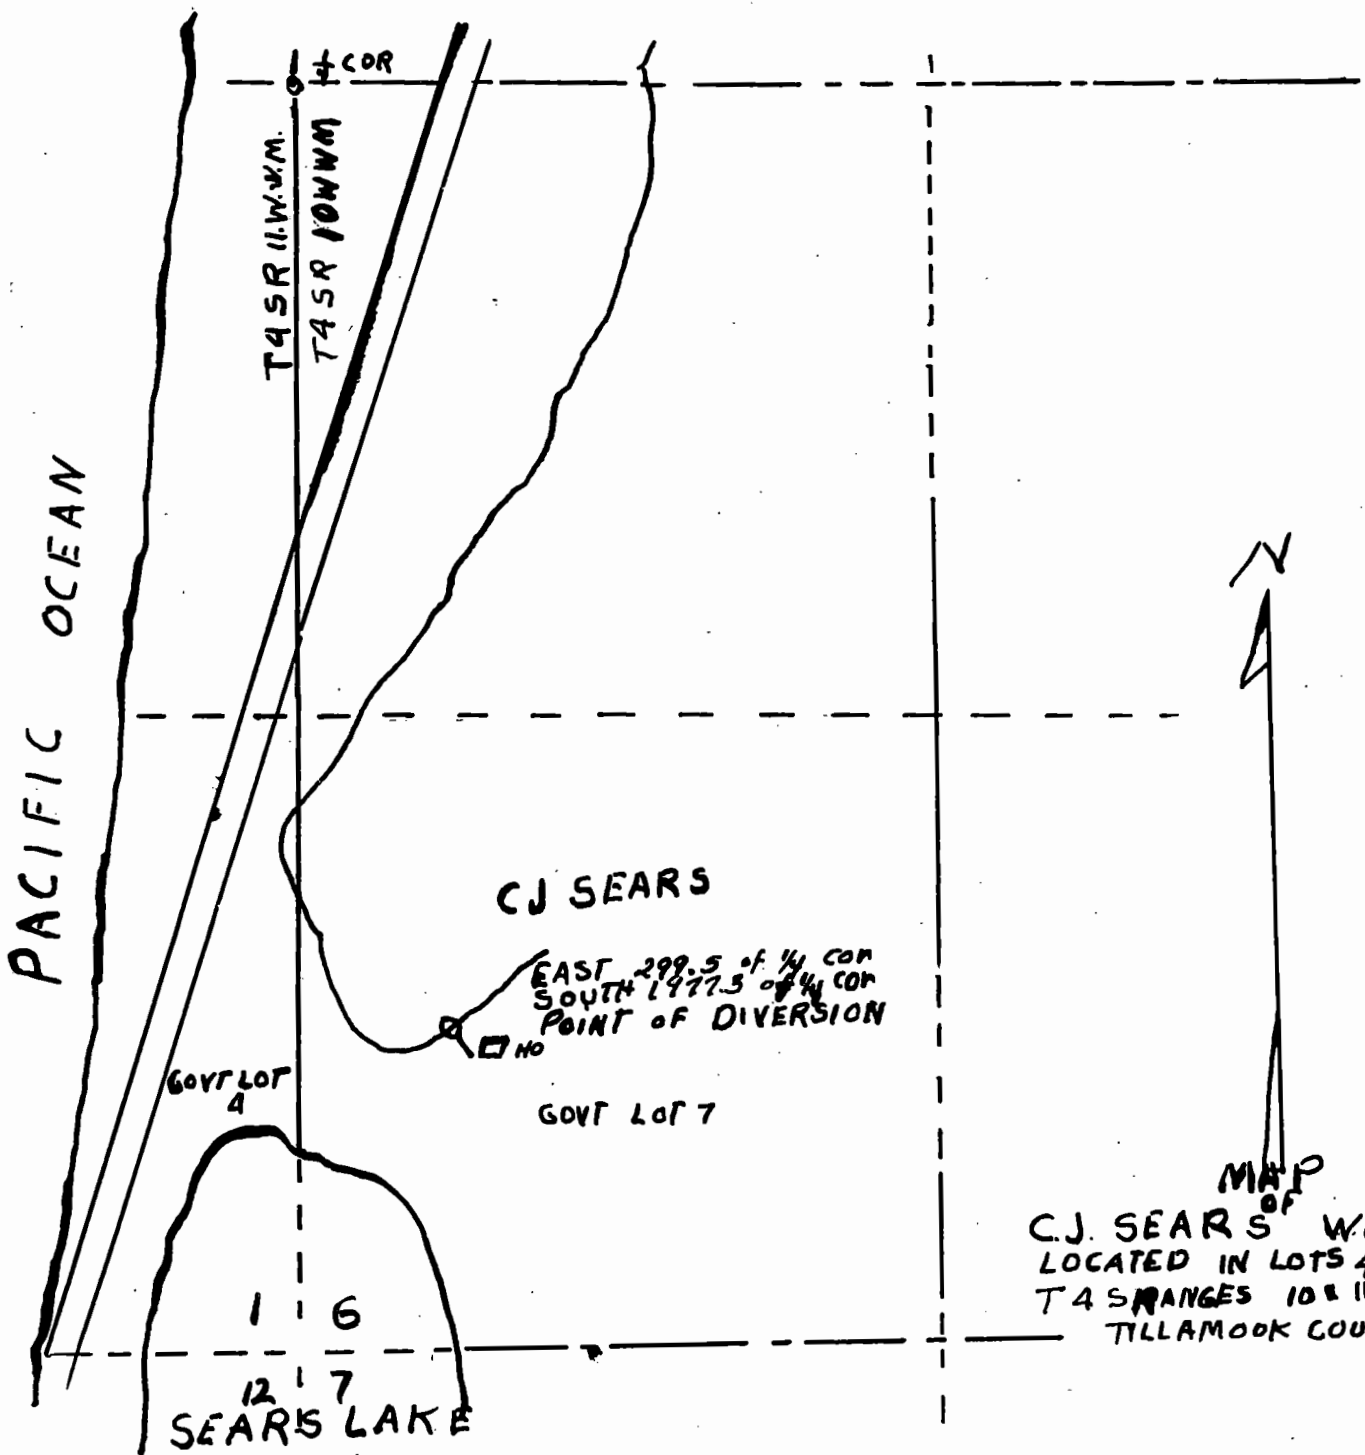

MAP  
 of  
 C.J. SEARS' WATER RIGHT  
 LOCATED IN LOTS 4-7 SECS 1-6  
 T45 RANGES 10 & 11 W W M  
 TILLAMOOK COUNTY ORE

RECEIVED  
 JAN 6 1954  
 STATE ENGINEER  
 BILLY CRONIN