


T. 1 S., R. 32 E., W. M.

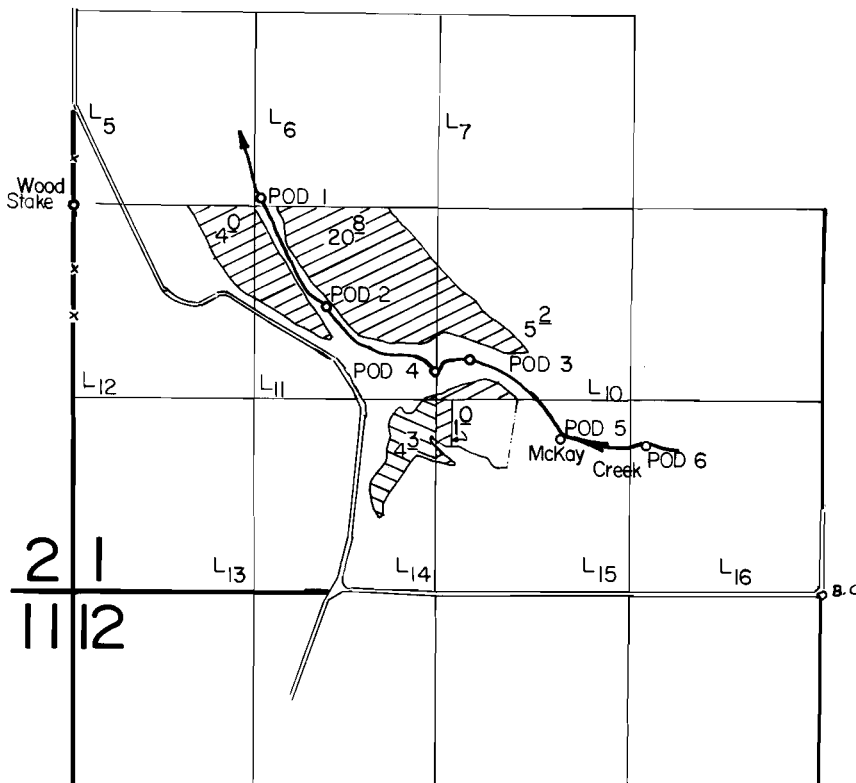

Scale: 1" = 1320'

POD's Loc. : 1 - 30' N. & 1290' E., 2 - 690' S.
 & 1730' E., 3 - 1060' S. & 2720' E.
 4 - 1110' S. & 2520' E., 5 - 1570' S. & 3340' E., 6 - 1640' S. & 3930' E.
 All Located from W. 1/4 Cor. Sec. 1.

FINAL PROOF SURVEY

UNDER

Transfer S-168 (POD's 5 & 6)

40376

30101

Application No. 50091... Permit No. 37639.....



IN NAME OF

J. E. & HELEN SUTHERLAND

Surveyed JUNE 28, 1971., by G. Baca.....
& 29

Oct. 16, 1975, by D. Norby