


T. 4S. R. 4W. W.M.

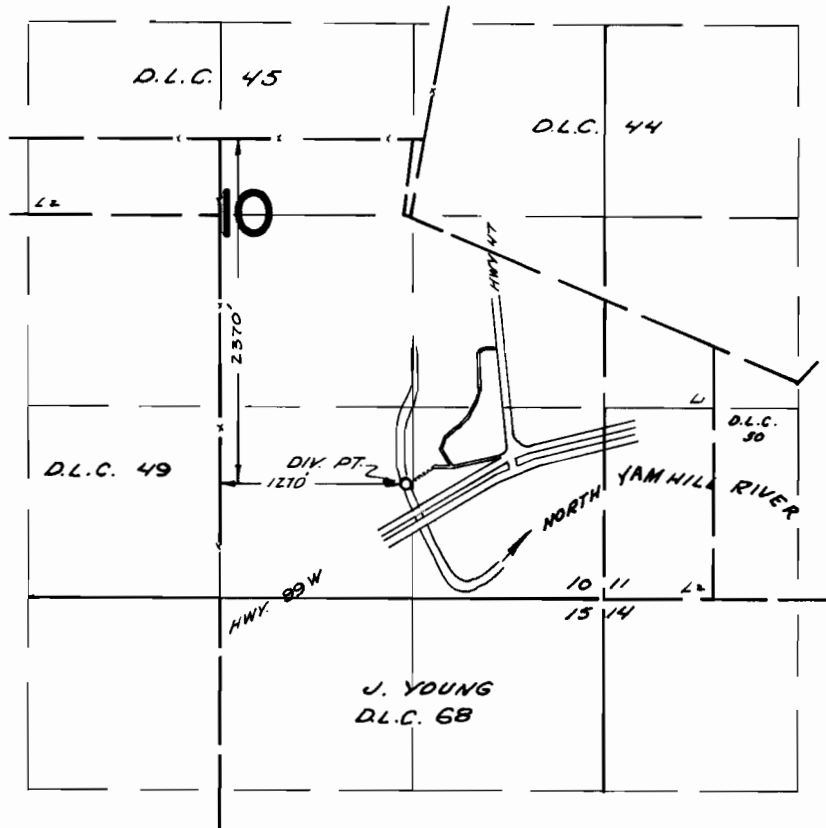

FINAL PROOF SURVEY UNDER

TRANSFER 5171
Application No. Permit No.
IN NAME OF

ST. JAMES CEMETERY ASSOCIATION

Surveyed Oct 20, 1967, by V. Garner