


T.2 N.R.10 E.W.M.

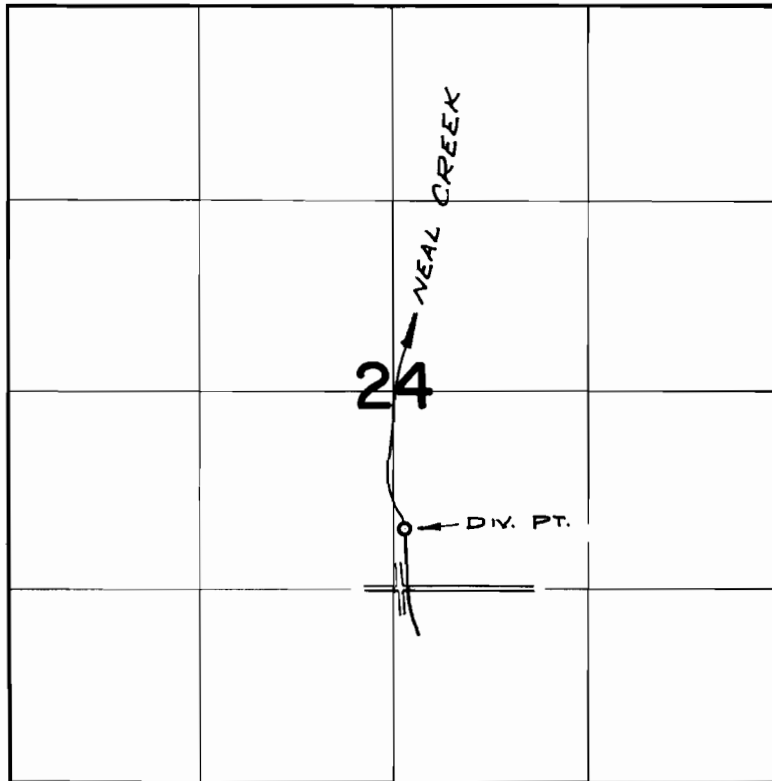

DIV. PT. LOC: 1740' N. & 80' E. FROM S $\frac{1}{4}$ COR. SEC. 24

FINAL PROOF SURVEY
UNDER

TRANSFER No. S-173

Application No. Permit No.
IN NAME OF

..... DANIEL SWAN

Surveyed APR. 23 1971, by G. BACA.....