


T.4S. R.3W.W.M.

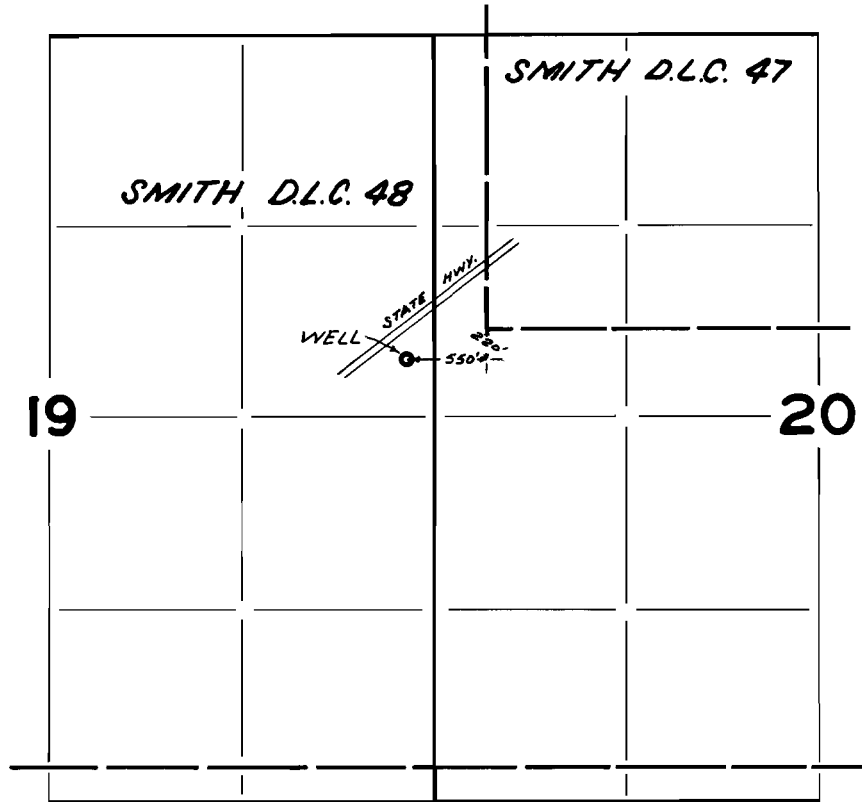

FINAL PROOF SURVEY
UNDER

TRANSFER No. S-179
Application No. Permit No.
IN NAME OF

SAMUEL B. SWEENEY

Surveyed JUN. 2. 1967, by V. GARNER