


T. 5N. R. 35E. W.M.

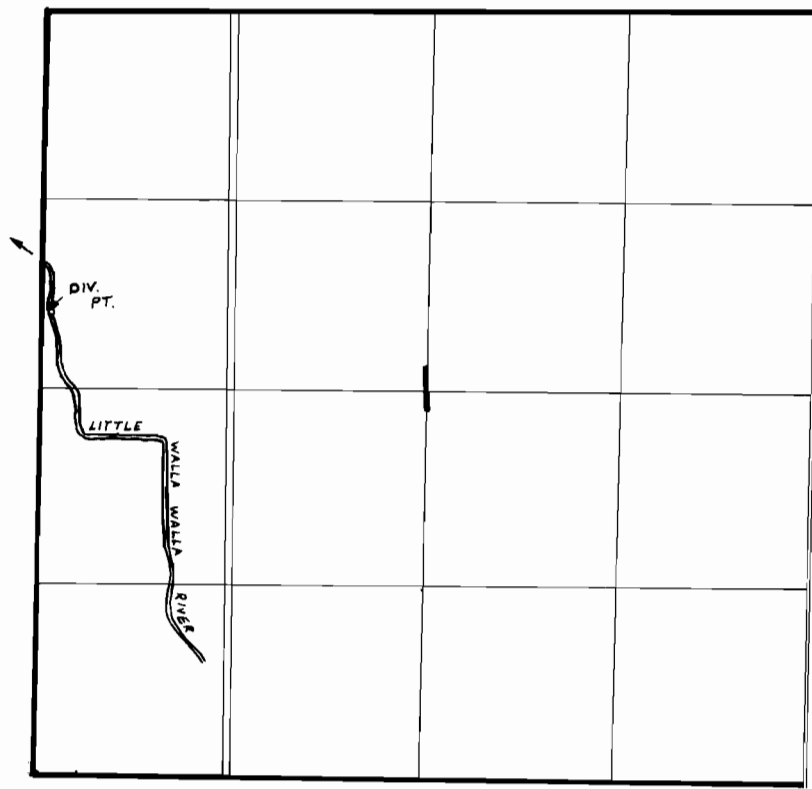

DIV. PT. LOC. 520'N & 80'E FROM W1/4 COR SEC 1

FINAL PROOF SURVEY
UNDER

TRANSFER S-181

Application No. Permit No.
IN NAME OF

CARL R. & SUE E. STEWART

Surveyed 9-25 1978, by R. BARWIN