


T.15S. R.11E. W.M.

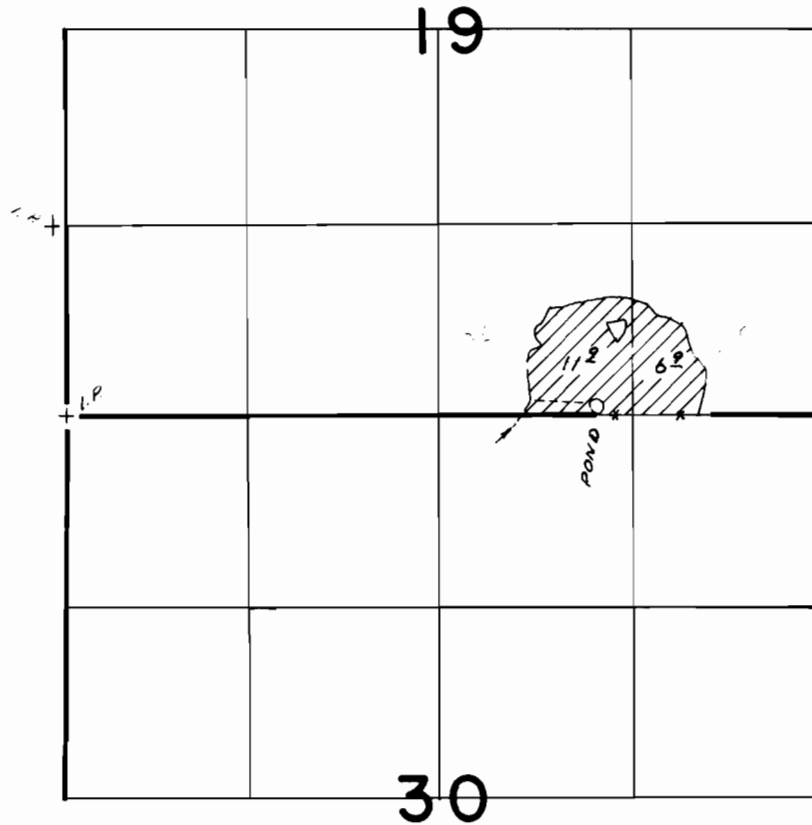


FINAL PROOF SURVEY
UNDER



A PORTION OF TRANSFER S-185
Application No. Permit No.
IN NAME OF

..... **DONALD VETTERLEIN**

Surveyed FEB. 21. 1980., by L.H. NUNN.....

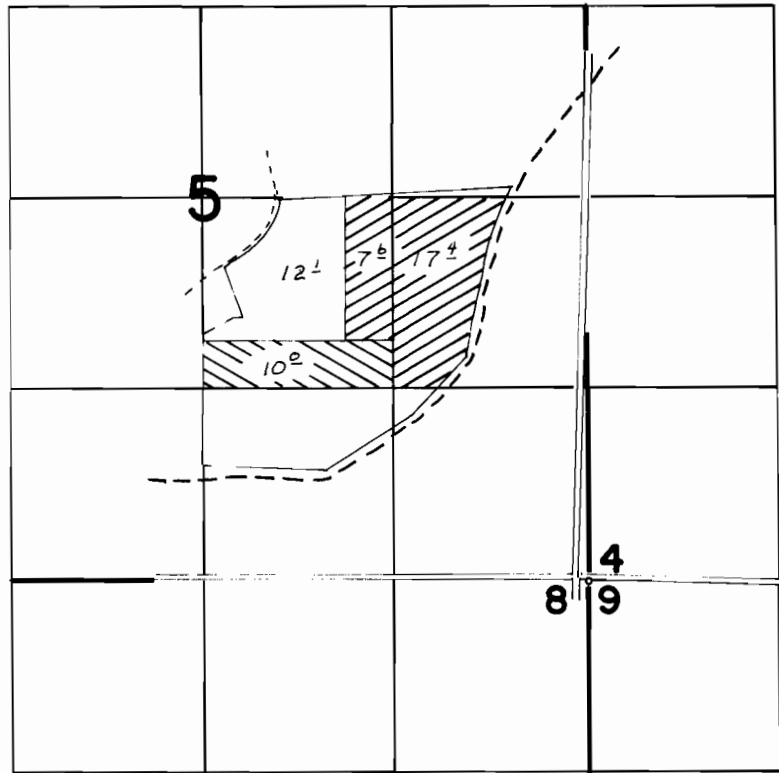T.15S. R.11E. W.M.



-  1889 PRIORITY
-  1895 PRIORITY

FINAL PROOF SURVEY UNDER


A PORTION OF TRANSFER S-185
Application No. Permit No.
IN NAME OF

WAYNE CLEMENS

Surveyed APR. 18. 1980., by L.H. NUNN.....

T.14S. R.11E. W.M.

SEC. 23

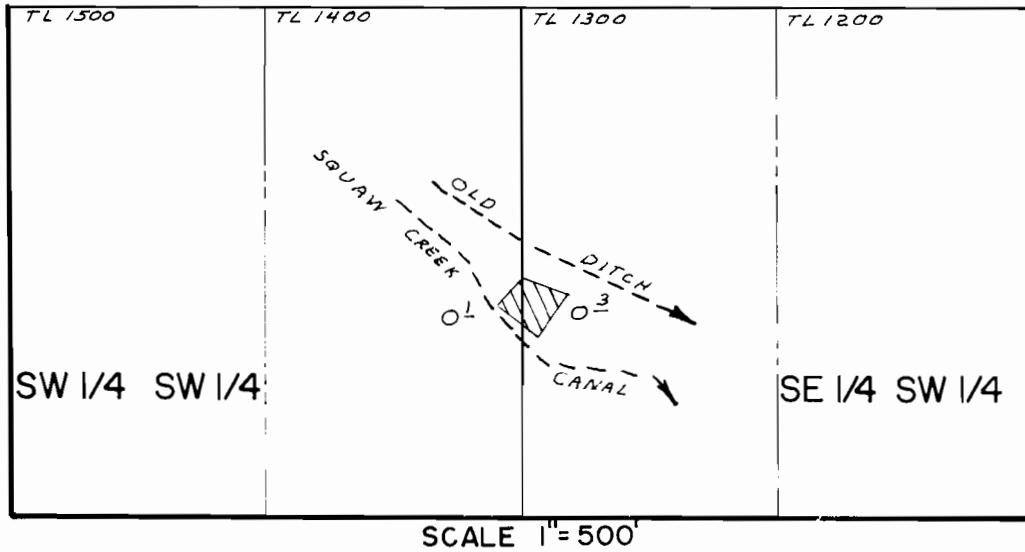

FINAL PROOF SURVEY
UNDER

A PORTION OF TRANSFER S-185
Application No. Permit No.
IN NAME OF

..... ROBERT BURDICK

Surveyed MAY..J..... 1980., by L.H. NUNN.....