


# T1S. R4W. WM.

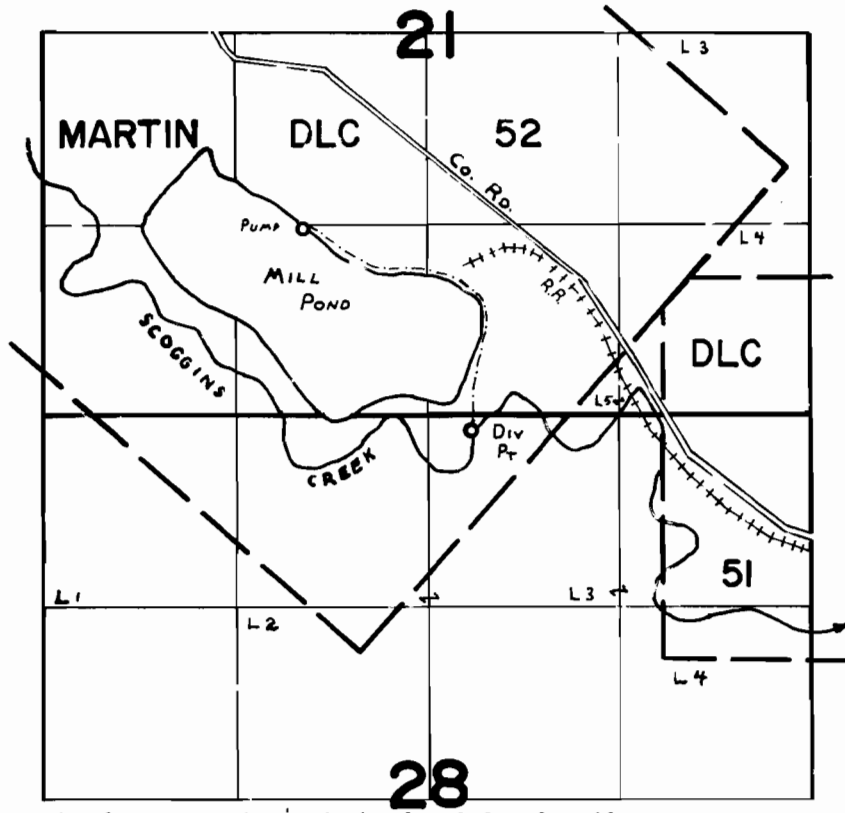

Div Pt Loc: 110'S & 2320'W fr. NE Cor. Sec. 28.

## FINAL PROOF SURVEY UNDER

TRANSFER S-211, T-3204  
Application No. \_\_\_\_\_ Permit No. \_\_\_\_\_  
IN NAME OF

STIMSON LUMBER CO.

Surveyed AUG 11 1978, by C. L. HUGHES.