


T.2S.R.11E.W.M.

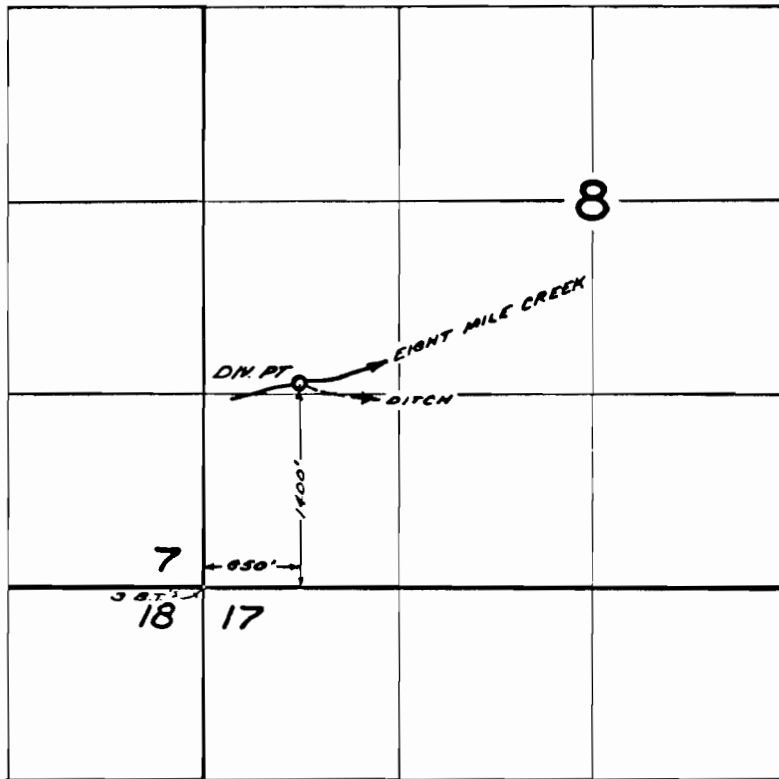

**FINAL PROOF SURVEY**  
UNDER

TRANSFER No. W-91  
Application No. .... Permit No. ....  
IN NAME OF

**WOLF RUN IRRIGATION COOPERATIVE, INC.**

Surveyed Nov. 14, 1967, by W. J. RUPPERT