


T.2S.R.11E.W.M.

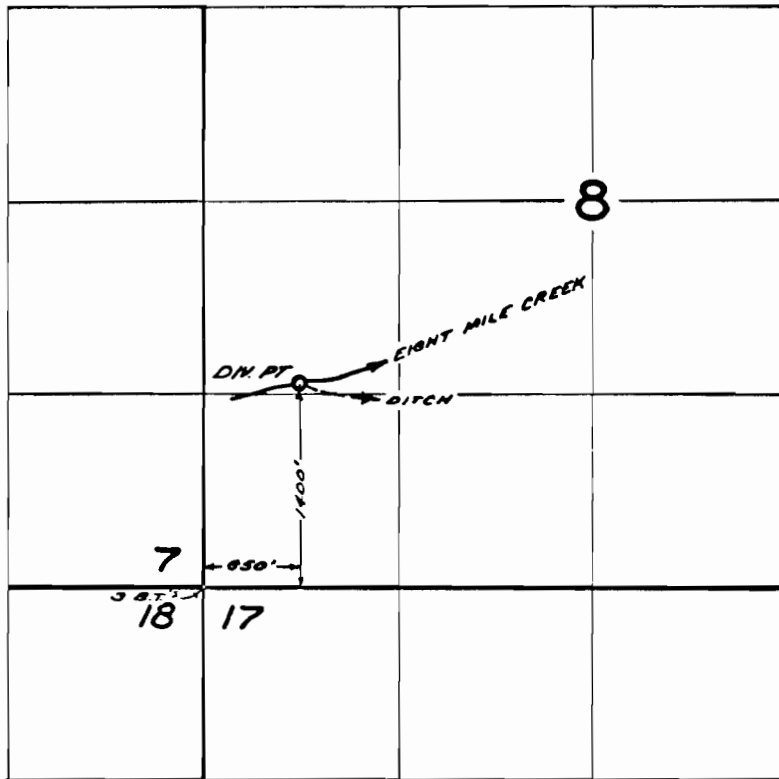

FINAL PROOF SURVEY
UNDER

TRANSFER No. W-91
Application No. Permit No.
IN NAME OF

WOLF RUN IRRIGATION COOPERATIVE, INC.

Surveyed *Nov. 14, 1967*, by *W. J. RUPPERT*