


RECEIVED
MAY 23 1969
STATE ENGINEER
SALEM, OREGON

T.26S. R.4W. W.M.

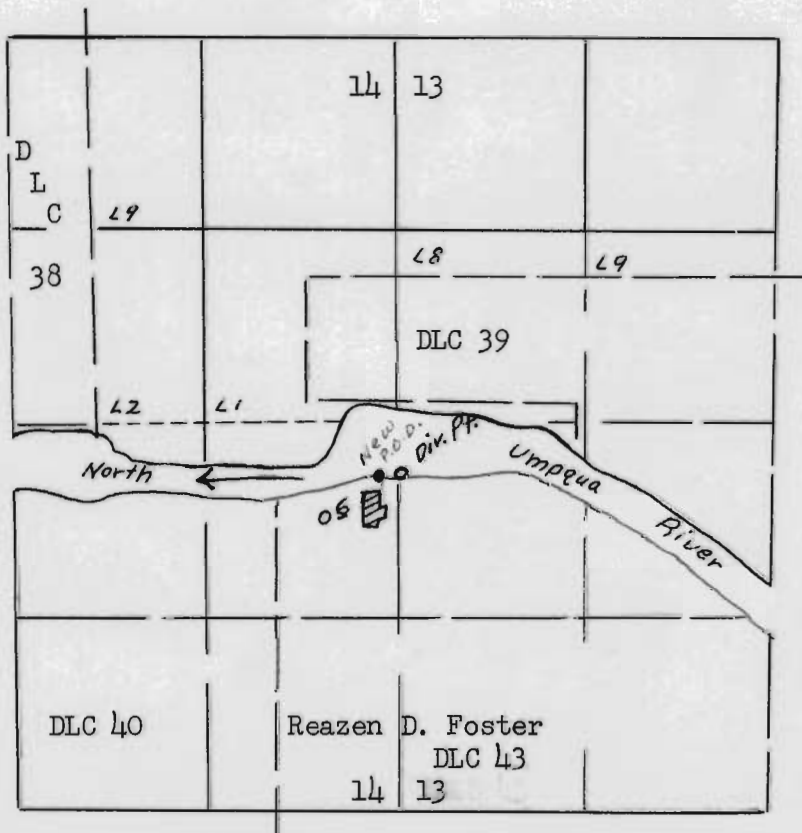

Scale 1"=400'

Old Point of Diversion - 2300 feet North and 20 feet East from SW corner of Section 13, T.26S., R.4W. W.M.

New Point of Diversion - 2300 feet North and 130 feet West from the SW corner of Section 13, T.26S., R.4W. W.M.