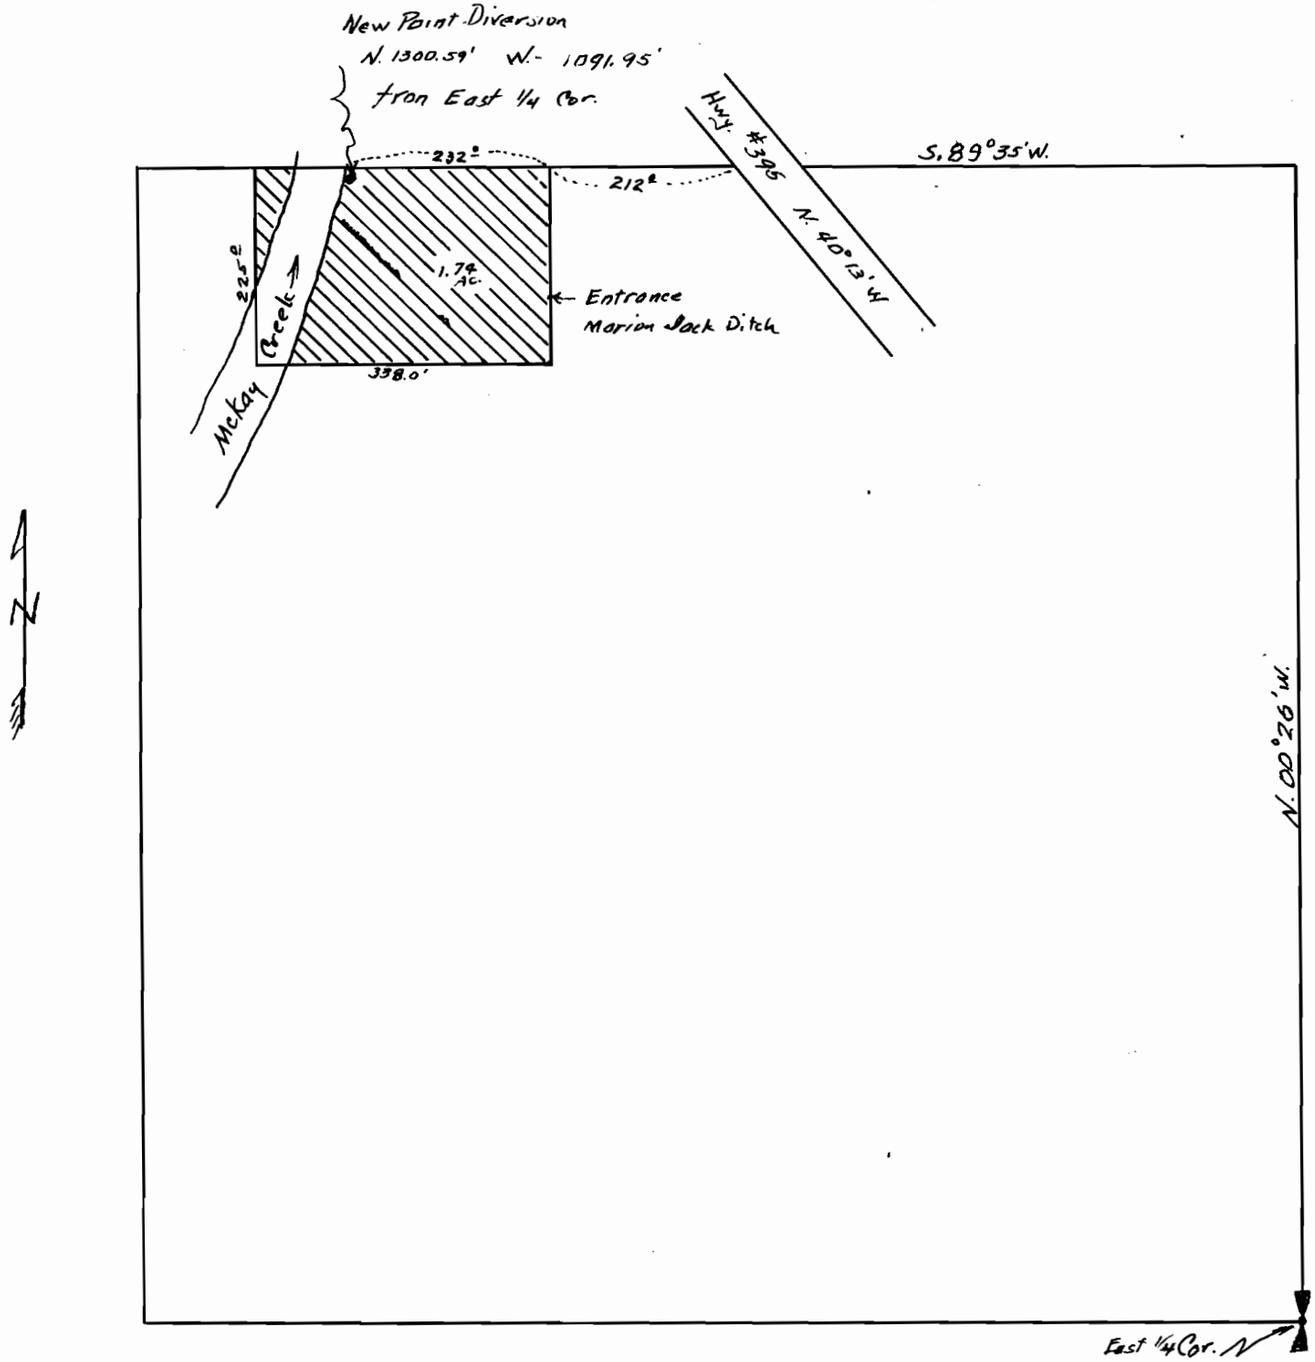

I, J.C. Payne, certify that this map was made from field notes on Feb. 25, 1956.

REGISTERED
OREGON
LAND SURVEYOR

J. C. Payne

J. C. PAYNE
NOV. 8, 1951
279

Diversion Point
for
Wayne Scott.

NE¼ Sec. 28, T. 2N., R. 32 E. W.M.

Date.-
Feb. 25, 1956

Scale:
1" = 200'