


Proposed  
Point of  
diversion

6S R37E.

Present  
Point of  
diversion

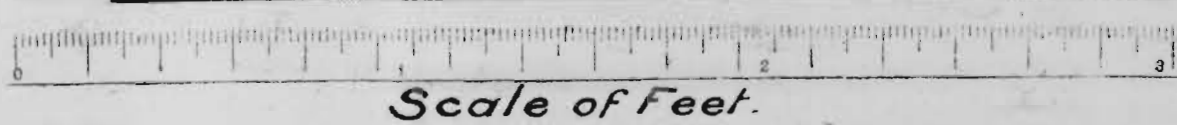

FROM OFFICE OF THE STATE ENGINEER, SALEM, OREGON

Survey By Rhea Luper June-July 1910

John H. Lewis, State Engineer

North Powder River Adjudication