


BAKER CITY 3 QUADRANGLE
OREGON

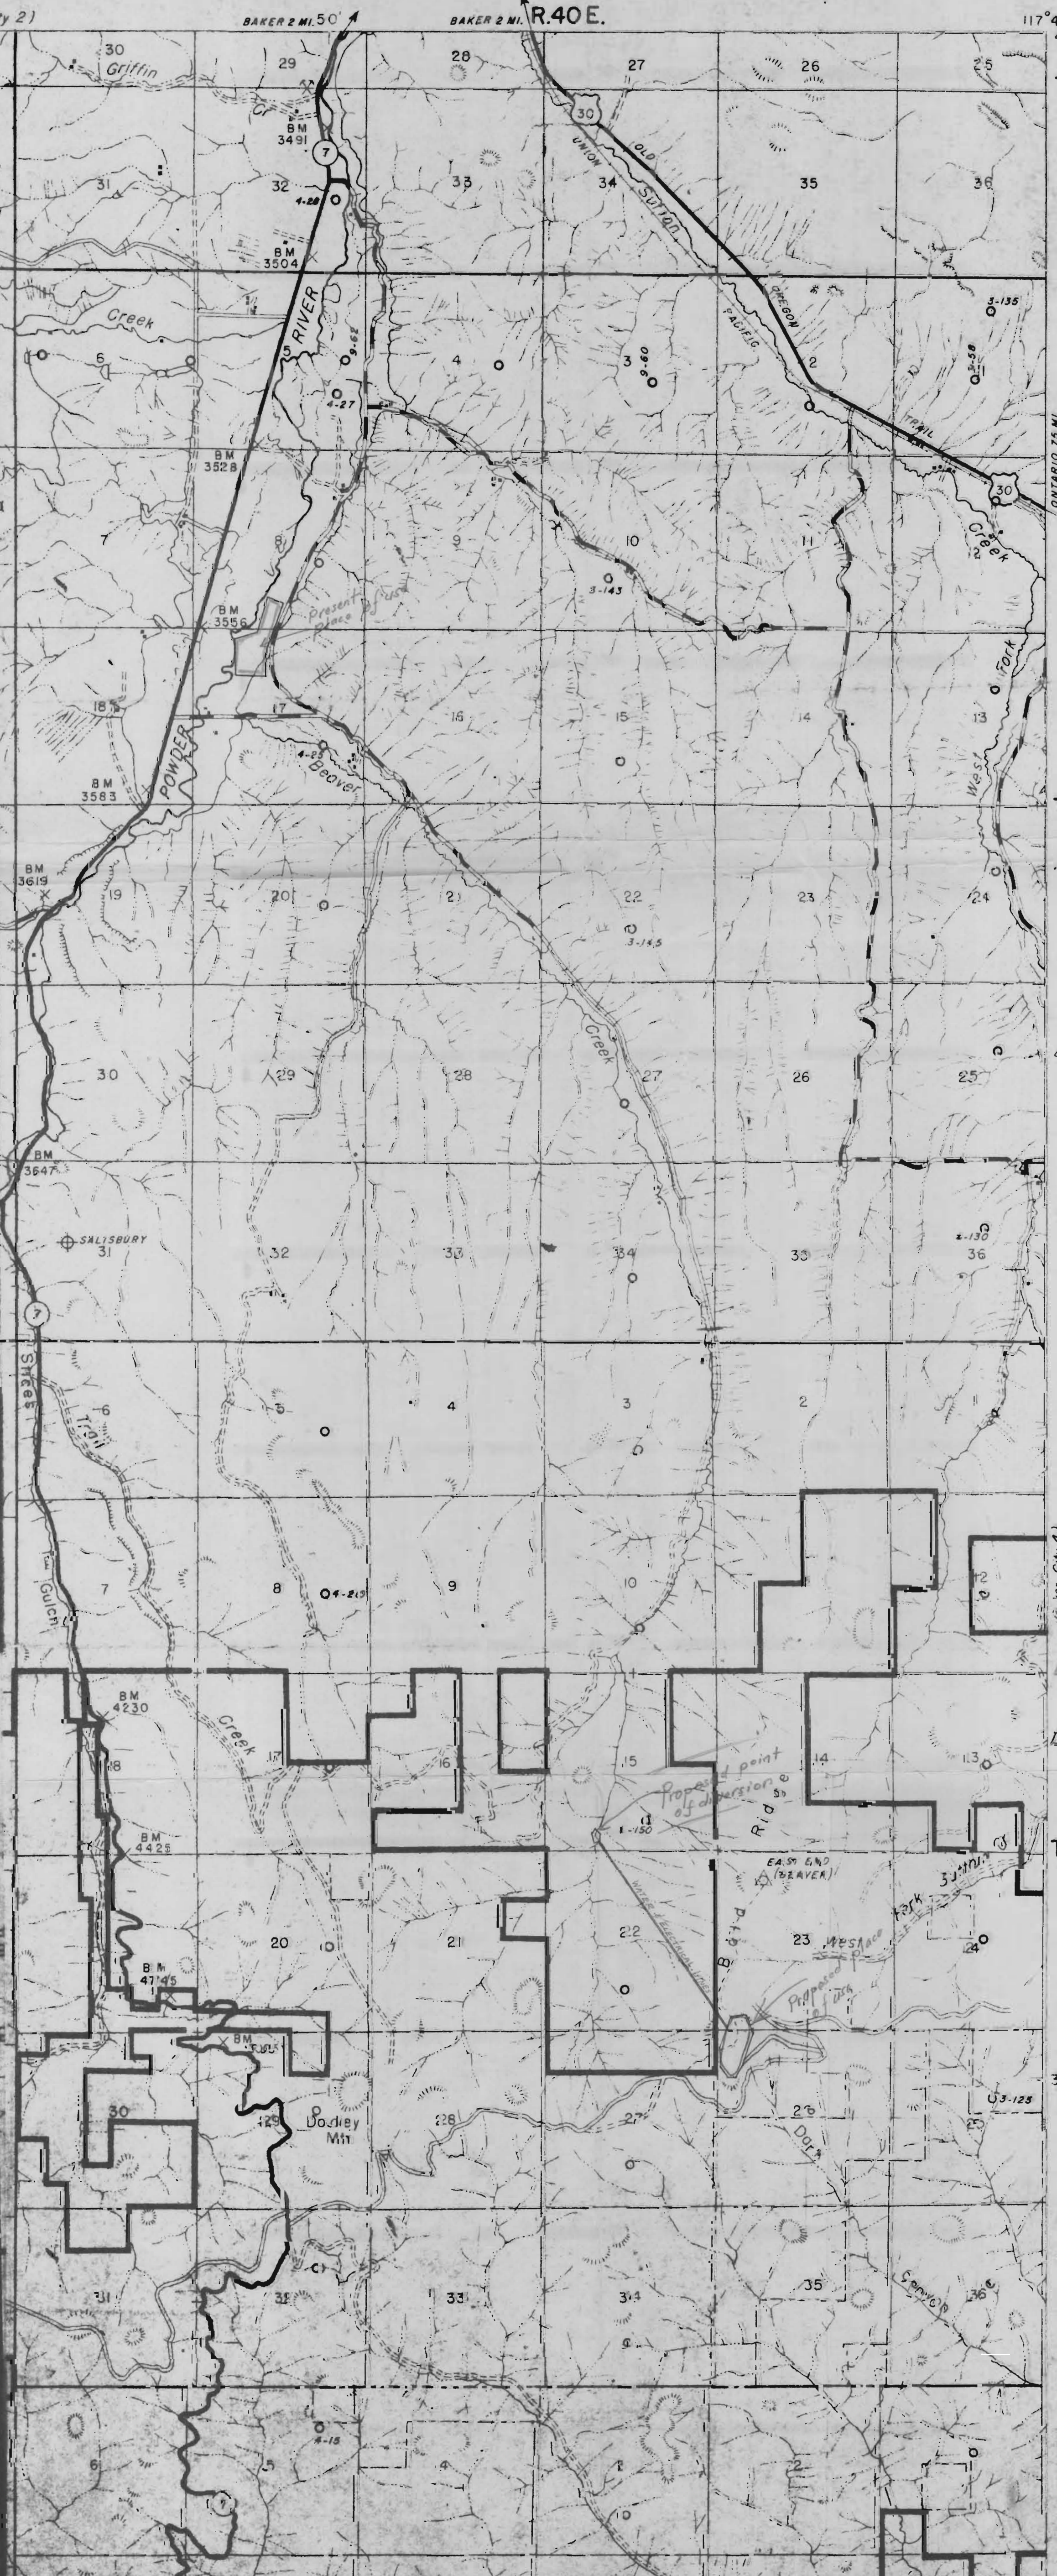

117° 45' 44' 45' W.
T. 9 S.
T. 10 S.

(Baker City 4)

Point of diversion of present Water Right

Proposed point of diversion of Water Right

T. 11 S.

RECEIVED
OCT 2 1961
STATE ENGINEER
SALEM, OREGON

35'