


A LAND TO BE EXCHANGED THROUGH TRANSFER
 B LAND UNDER NEW APPLICATION

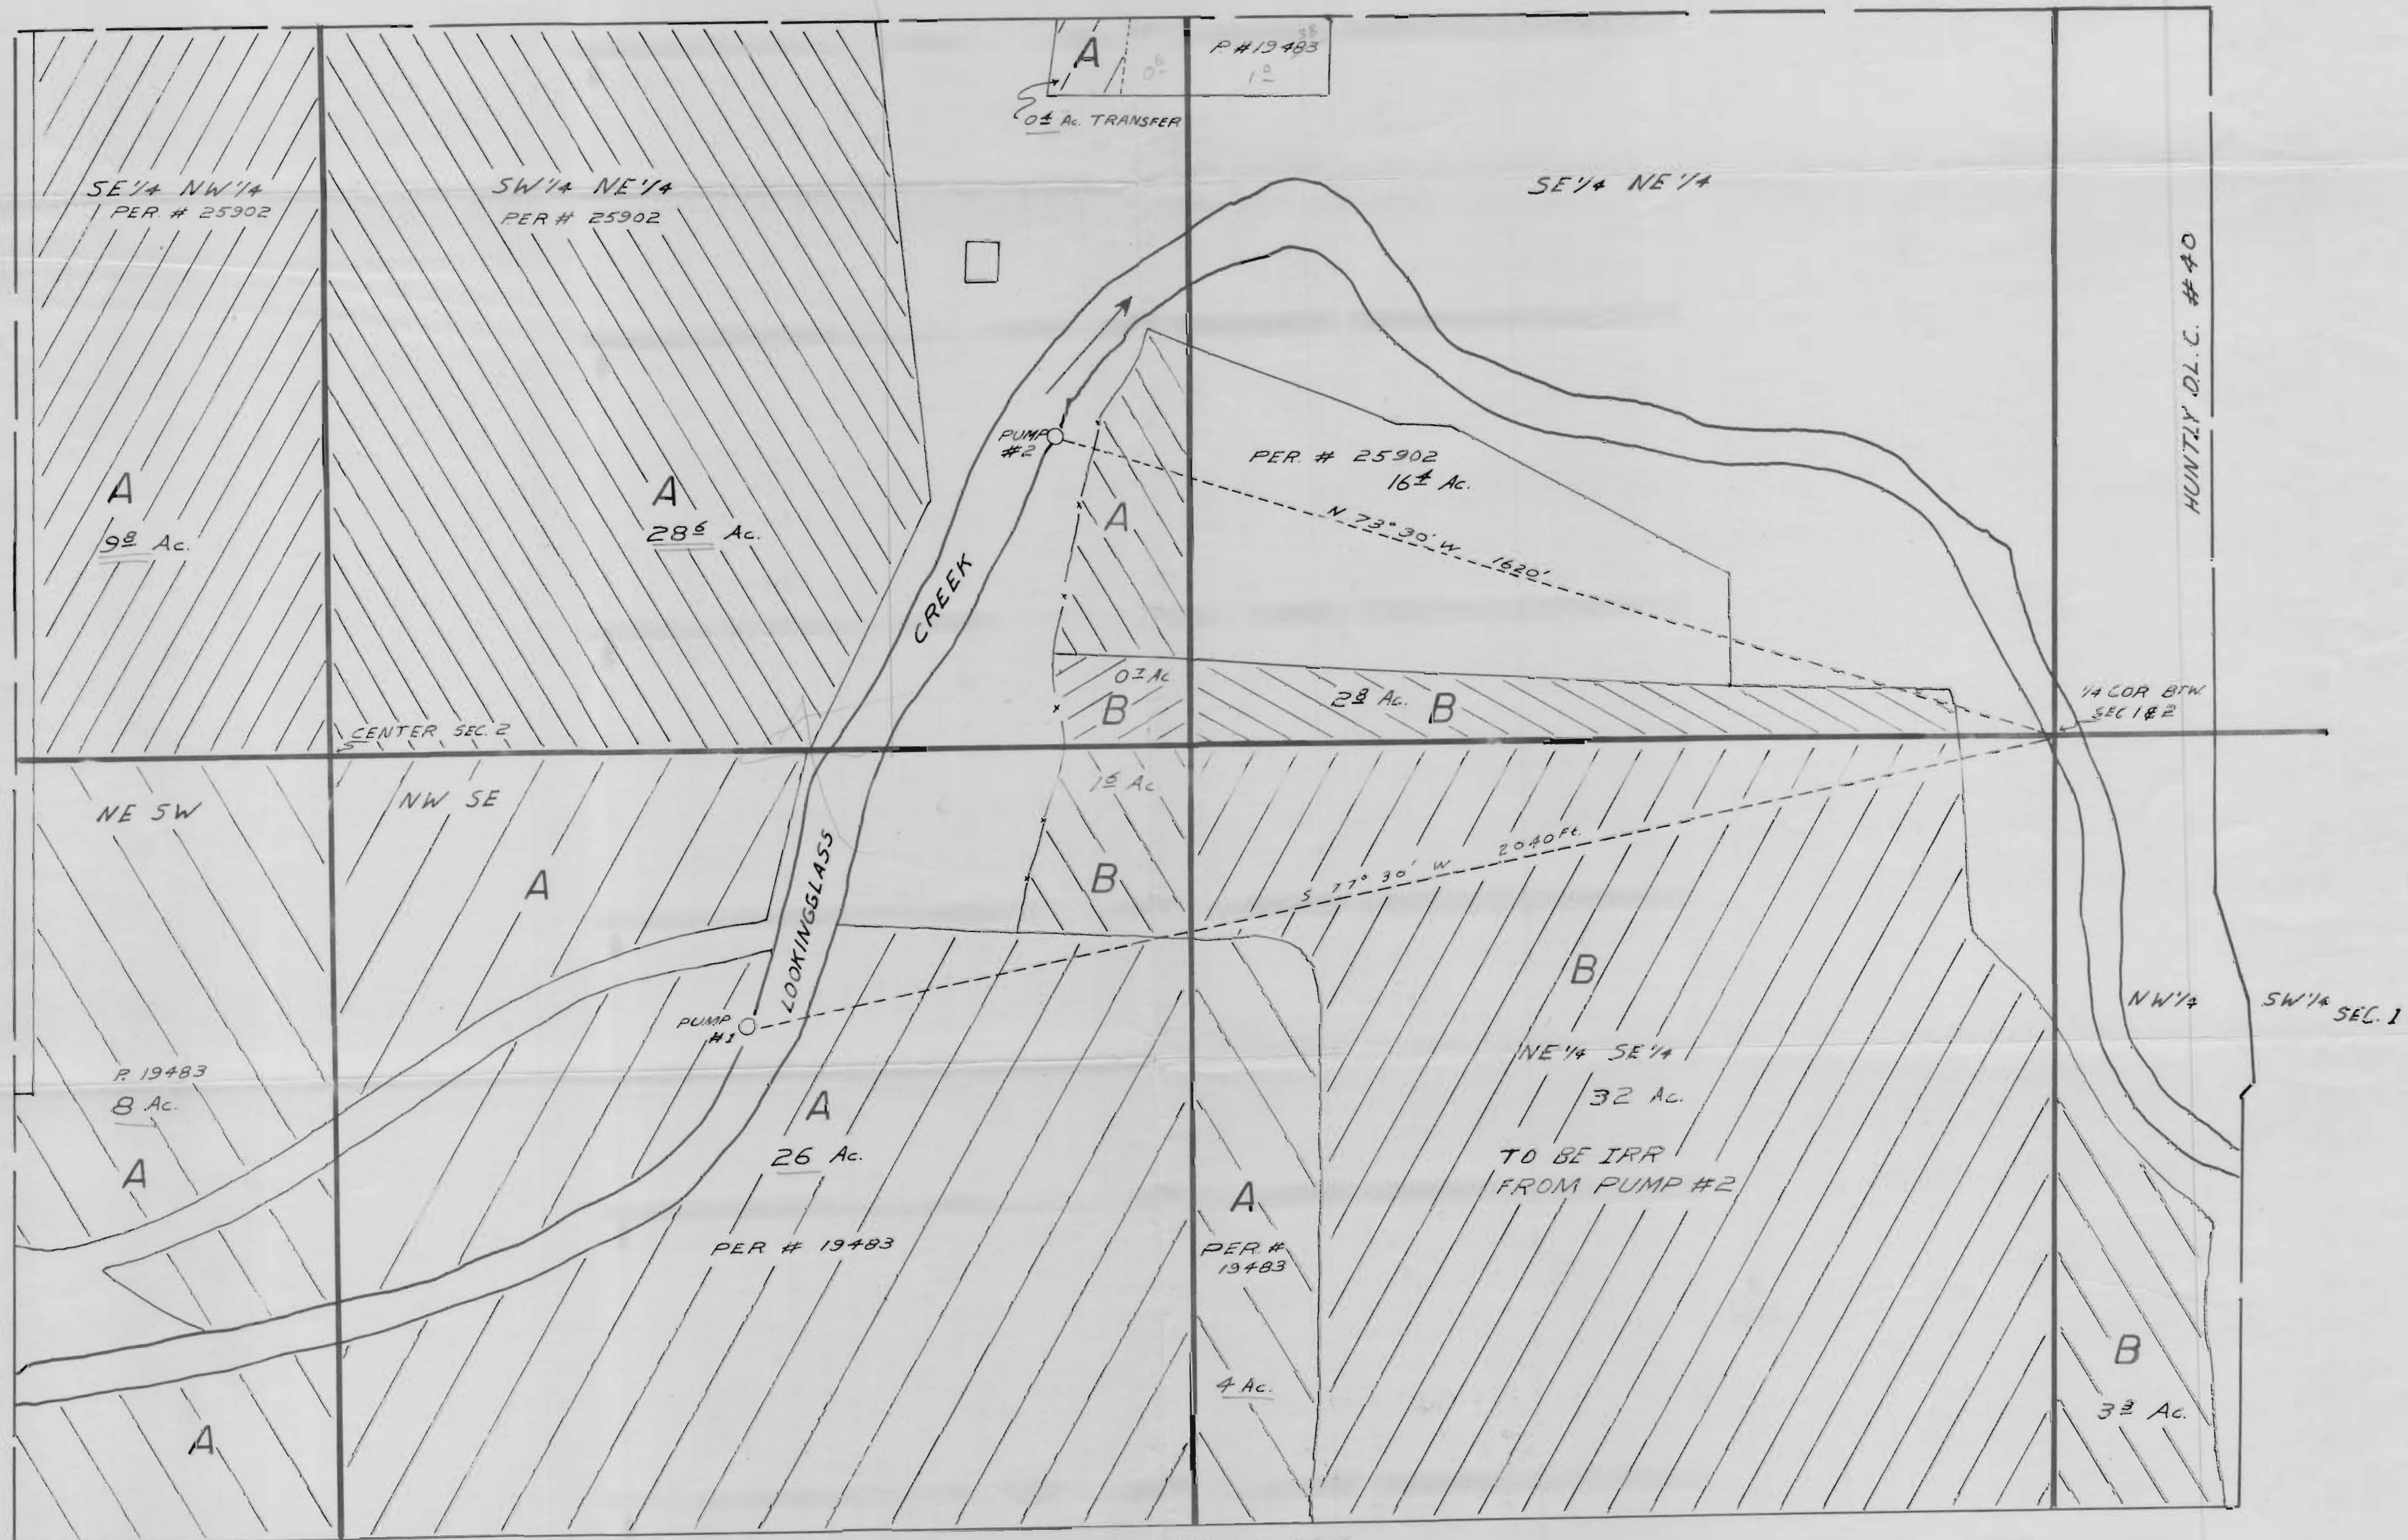

T.28S. R.7W. W.M.
 SCALE 1"=200'

Application No. 41161-5174
 Permit No.