
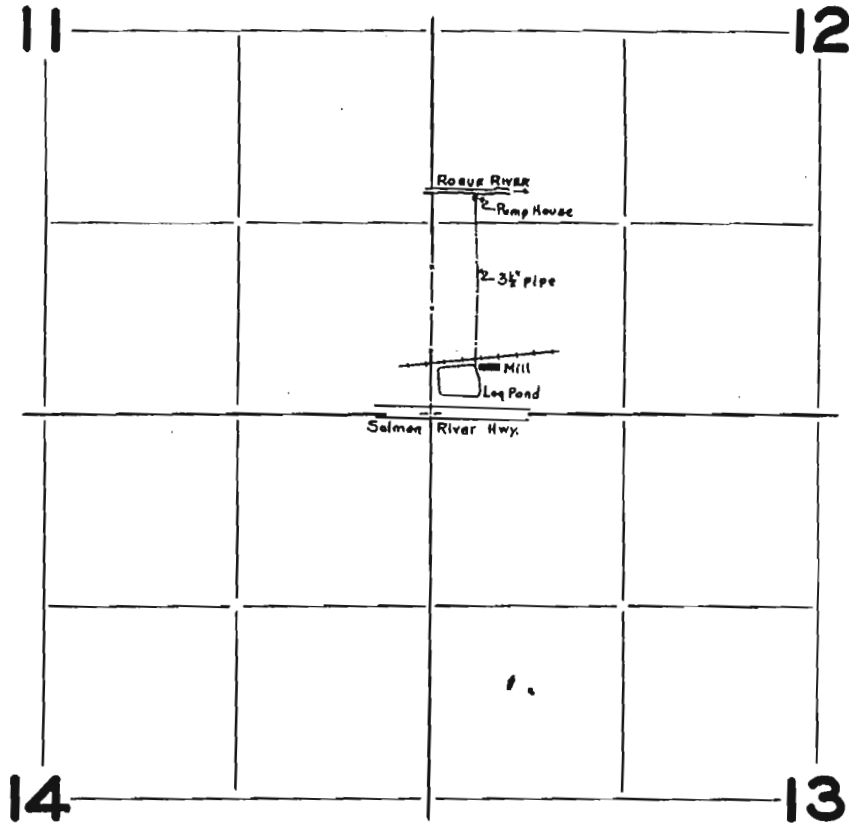


T. 6 S.. R. 8 W. W.M.

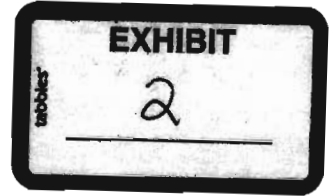

FINAL PROOF SURVEY

UNDER

Application No. ^{R-19456} 12457 Permit No. ^{R-171} 15049

IN NAME OF

Coastal Lumber Company

Surveyed June 19 1942, by Geo. W. Maderman

RECEIVED

APR 28 2005

WATER RESOURCES DEPT
SALEM, OREGON