


T.29S.,R.6W.,W.M.

SECTION 30

NE 1/4 SW 1/4

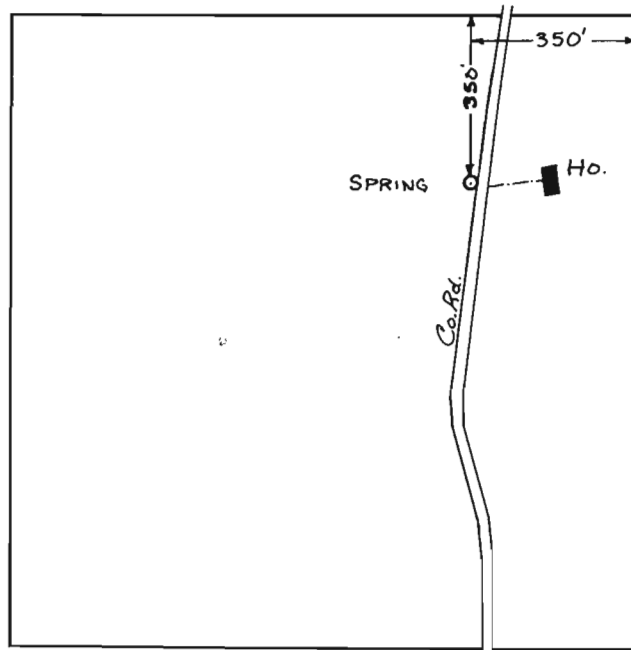

SCALE: 1"=400'

FINAL PROOF SURVEY

UNDER

Application No. 51868.. Permit No. 39152.....
IN NAME OF

.....WILLIAM G. WHITNEY.....

Surveyed April 3... 1979., by J.S. DONALDSON