


POINT OF DIVERSION TRANSFER APPLICATION FOR
 AVION WATER COMPANY, INC.
 LOCATED IN SECTION 28
 TOWNSHIP 15 SOUTH, RANGE 12 EAST, WM
 CROOK COUNTY, OREGON
 AUGUST 8, 2003

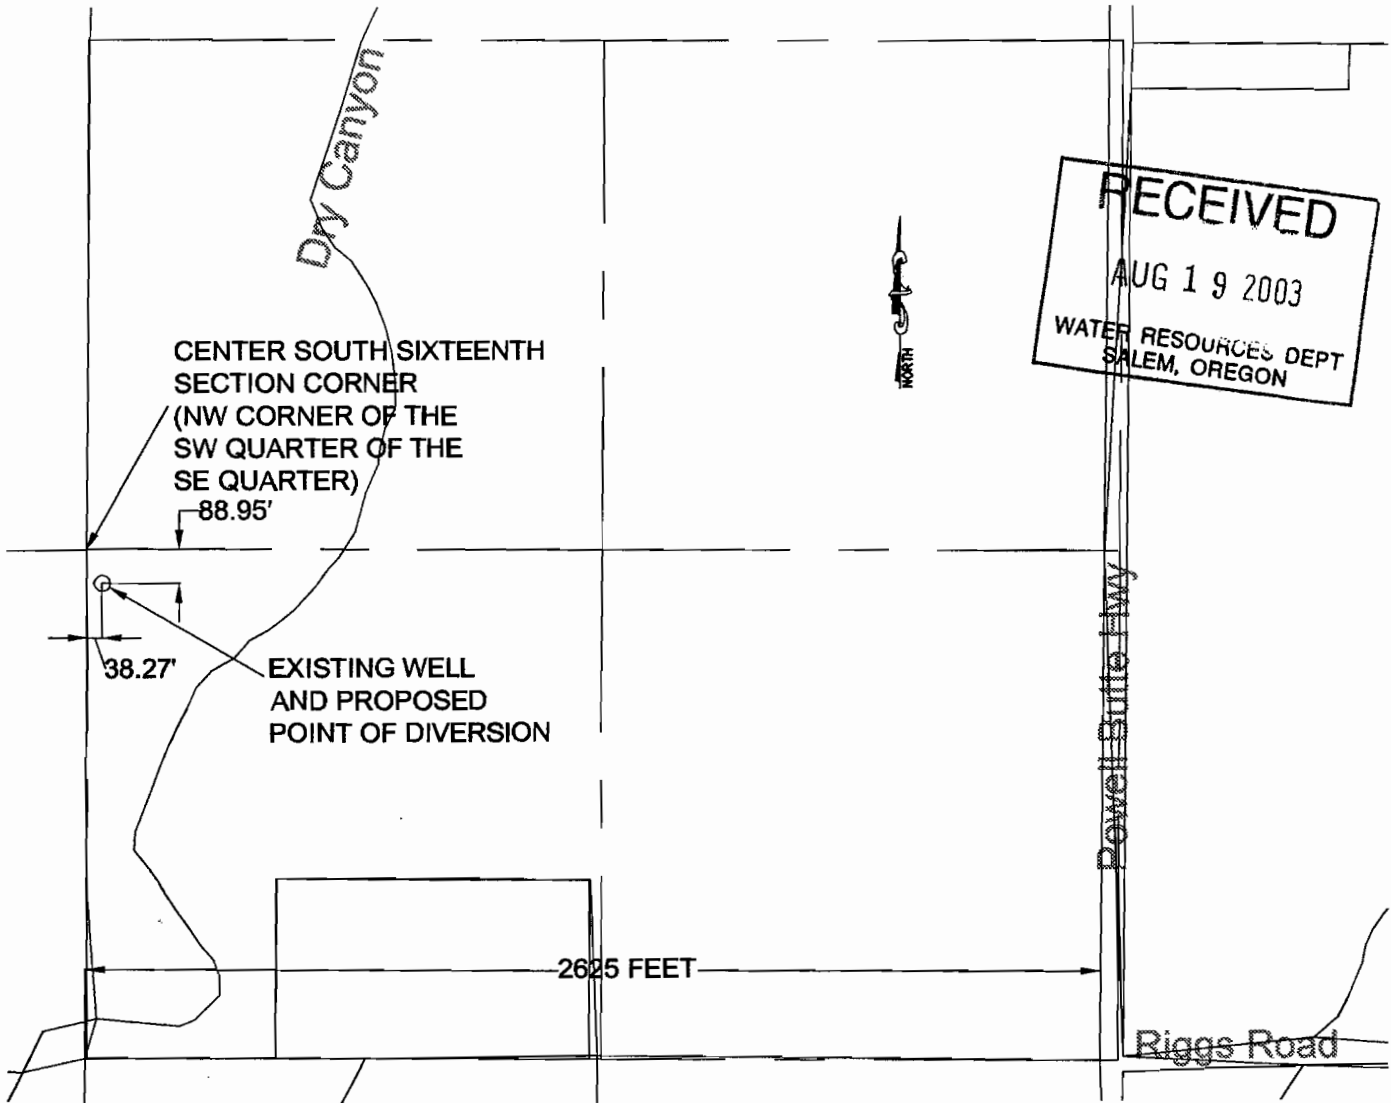

RECEIVED
 AUG 19 2003
 WATER RESOURCES DEPT
 SALEM, OREGON

Certified Water Right Examiner
 #137
Thomas A. Walker
 Thomas A. Walker
 Nov. 19, 1987
 STATE OF OREGON
 EXPIRES 6-30-04

NOTE: THIS MAP WAS PREPARED TO IDENTIFY THE LOCATION OF WATER RIGHTS. THIS MAP IS NOT INTENDED TO PROVIDE DIMENSIONS OR THE LOCATION OF PROPERTY OWNERSHIP LINES.

Office: BEND / System: WHP-BND-JKWS701 / User: CSCHNEIDER

DESIGNED BY: _____		CHECKED BY: _____		
DRAWN BY: _____		APPROVED BY: _____		
LAST EDIT: _____		PLOT DATE: 08/08/03		
DATE	BY	REV#	REVISION	CK'D/APPR

920 Emkay, Suite C-100
 Bend, Oregon
 97702-1041
 (541) 338-2200
 (541) 338-2229 Fax
 whpacific.com

AVION WATER COMPANY, INC

POINT OF DIVERSION TRANSFER

CROOK			OREGON
SCALE: 1"=500'	PROJECT NO.	DRAWING FILE NAME:	SHEET

T-9525