

Map of Beneficial Use

Under

APPLICATION T-8745

in the name of

STANLEY STARR, Selling Owner

4691 S.W. Hollyhock Circle

Corvallis, OR 97333

PATRICK & RHONDA HYNES, Receiving Owner

4835 NW Hwy. 20

Corvallis, OR 97333

Date of Site Inspection: September 26, 2000

Date of Map: June 21, 2001

Tax Lot: 701 (11-4-17)

Source: A well in the Willamette River Basin.

Area of Irrigation

Under Certificate No. 36962, there are 17.0 acres being put to beneficial use as specified by quarter-quarter sections on the herein attached map.


I, JACK R. BURRELL, BEING DULY SWORN AS A WATER RIGHT EXAMINER, LICENSE NO. 209, HAVE PREPARED THIS MAP FOR STANLEY STARR ON THIS 21ST DAY OF JUNE, 2001. THE AREAS HATCHED REPRESENT THE ACREAGE'S BEING IRRIGATED AT THE TIME OF THE SITE INSPECTION CONDUCTED ON SEPTEMBER 26, 2000.

PREPARATION OF THIS MAP IS FOR THE PURPOSE OF IDENTIFYING THE LOCATION OF THE WATER RIGHT ONLY AND HAS NO INTENT TO PROVIDE DIMENSIONS OR LOCATION OF PROPERTY OWNERSHIP LINES.


LEGEND:



PORTION OF PROPERTY TO BE IRRIGATED IS DEFINED BY DIAGONAL HATCHING
17.0 acres

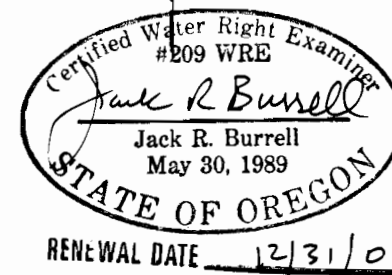

RECEIVED

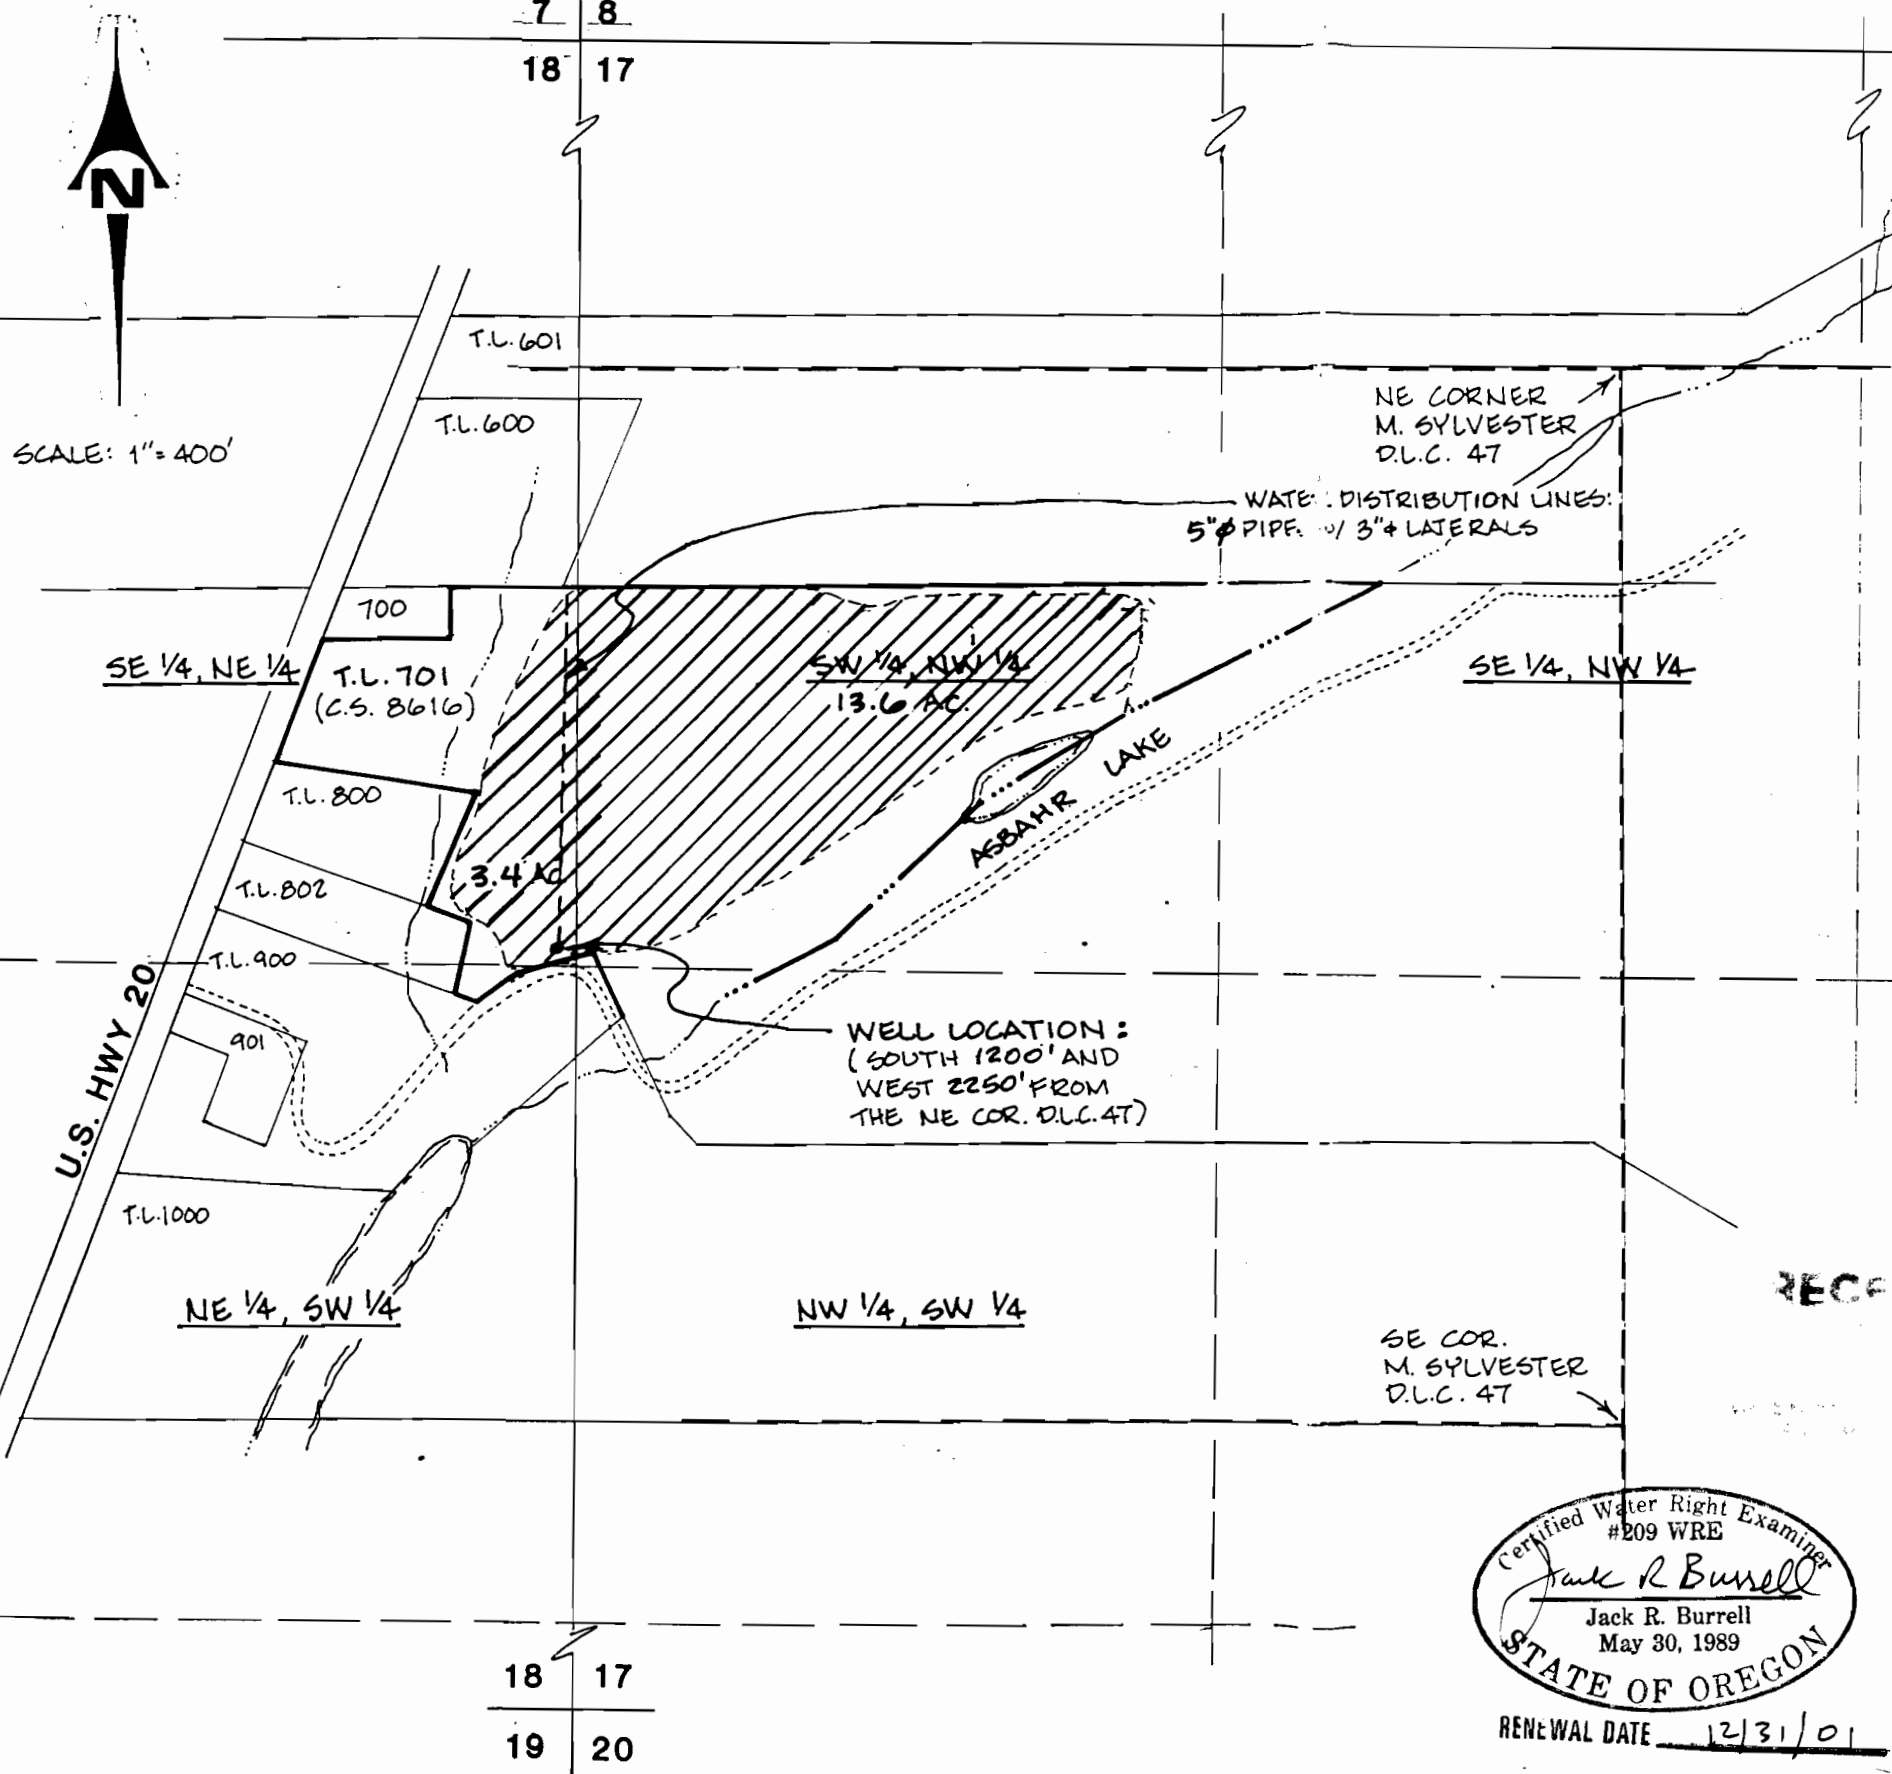

KD ENGINEERING, INC.
 202 NW HICKORY STREET
 POST OFFICE BOX 725
 ALBANY, OREGON 97321

STARR WATER RIGHTS
 Sections 17 & 18, T.11 S., R. 4 W., W.M.,
 BENTON COUNTY, OREGON

DSGN. BY: J.R. BURRELL	SCALE: 1" = 400'	SHEET NO.
DWG. BY: E.J.R.	DATE: JUNE 21, 2001	1 of 1
CKD. BY: J.R.B.	PROJECT NO.: 92-108	