


T. 27S., R. 15E., W. M.

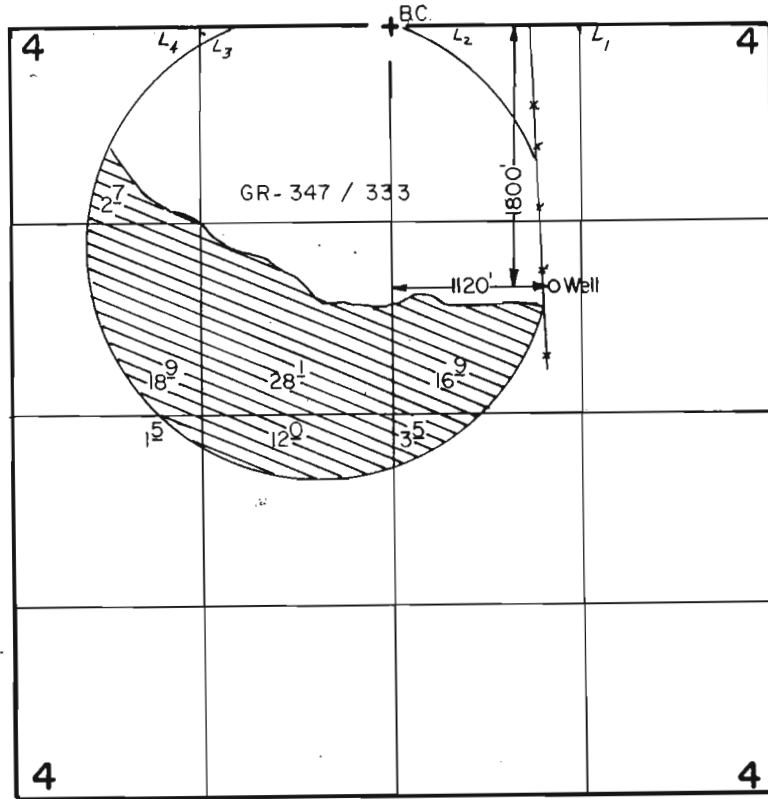

Scale : 1" = 1320'

**FINAL PROOF SURVEY**  
UNDER

Application No. G-10917... Permit No. G-10111.....  
IN NAME OF

**POPLARS RANCH, INC.**

Surveyed Sept. 12... 1985., by J. Warren.....