



Additional POA-3 located
610 feet North, 250 feet
West of Southeast Corner of
T14S, R11E Section 14

Section 13 SWSW – 25.5 acres
Section 14 SESE – 5.5 acres
Section 23 NENE – 7.5 acres
Section 24 NWNW – 6.0 acres

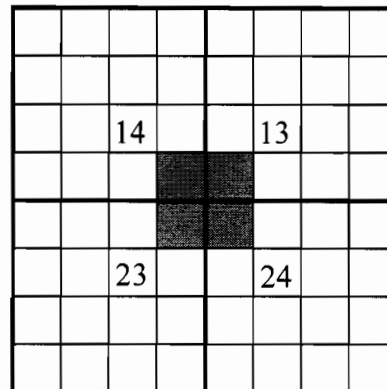

Township 14 South
Range 11 East

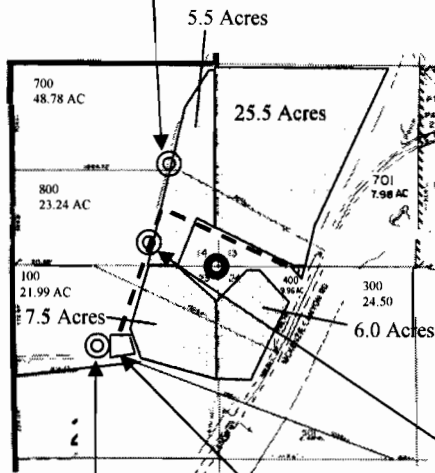


North

Pond with 30 HP pump
feeding buried mainline

Additional POA-2 DESC
1976 located 125 feet North,
420 feet West of Southeast
Corner of T14S, R11E
Section 14

Authorized POA - DESC
1969 located 600 feet South,
820 feet West of Northeast
Corner of T14S, R11E
Section 23

Water Right Map for Certificate 82185 with additional Points of Appropriation

● Section Corner Marker Location ⊙ Well Locations  Place of Use - - - Buried Mainline

T14S R11E Sections 13, 14, 23 & 24 Tax Lots 100,400,700,800

1 inch equals 1320 feet

November 13, 2009

John A. Short
P.O. Box 1830
Bend, OR 97709
541-408-7415
johnshort@usa.com

