



Township 5 South, Range 1 West, W. M.
 Portions of Sections 34 & 35

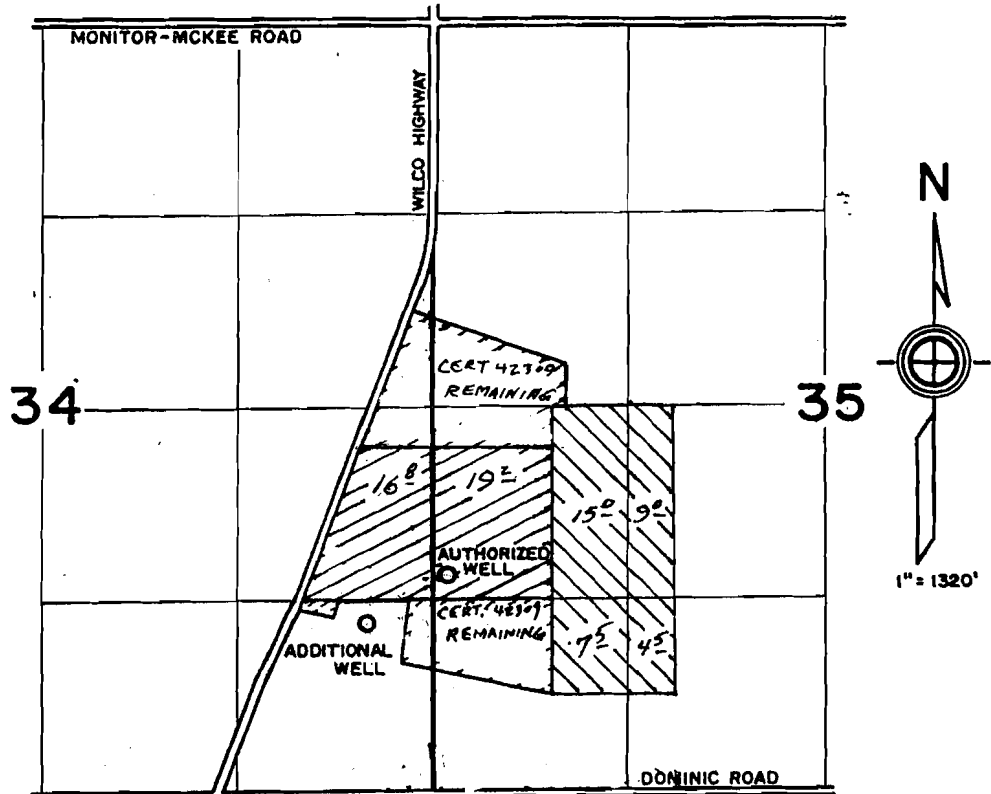

WELLS LOCATED: AUTHORIZED - 1500' N. and 130' E., ADDITIONAL - 1170' N. and 450' W.;
 Both from the SW cor. Sec. 35.

FROM  TO 

Temporary Map to Accompany
 Transfer Application
 in the name of
CHRIS BOCHSLER

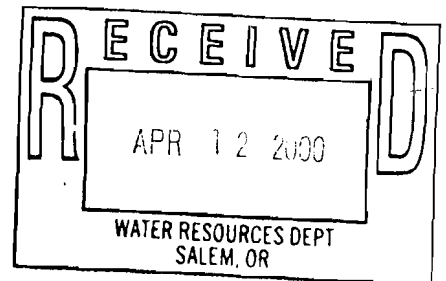

Trans. No. 8491