


La Grande Country Club G-2969-

T.3S.R.38E.W.M.

RECEIVED

SEP 23 2005

WATER RESOURCES DEPT
SALEM, OREGON

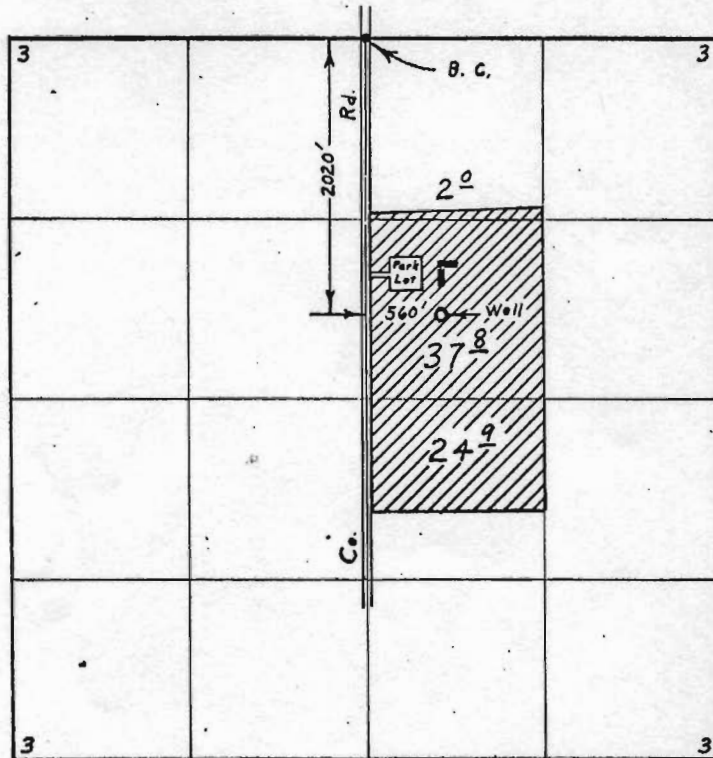

Transfer Application Map

FINAL PROOF SURVEY
UNDER

Application No. G-3155 Permit No. G-2969
IN NAME OF

THE LA GRANDE COUNTRY CLUB

Surveyed Oct. 27, 1966, by L. E. Gould

RECEIVED

DEC 19 2005

WATER RESOURCES DEPT
SALEM, OREGON

1966-X