


02.0 - 4/2/04 - map

PROPOSED ALTERNATE POINT OF DIVERSION FOR C 3977 T.7S.; R.30E.; W.M.

RECEIVED APR 02 2004 WATER RESOURCE DEPT. EASTERN REGION

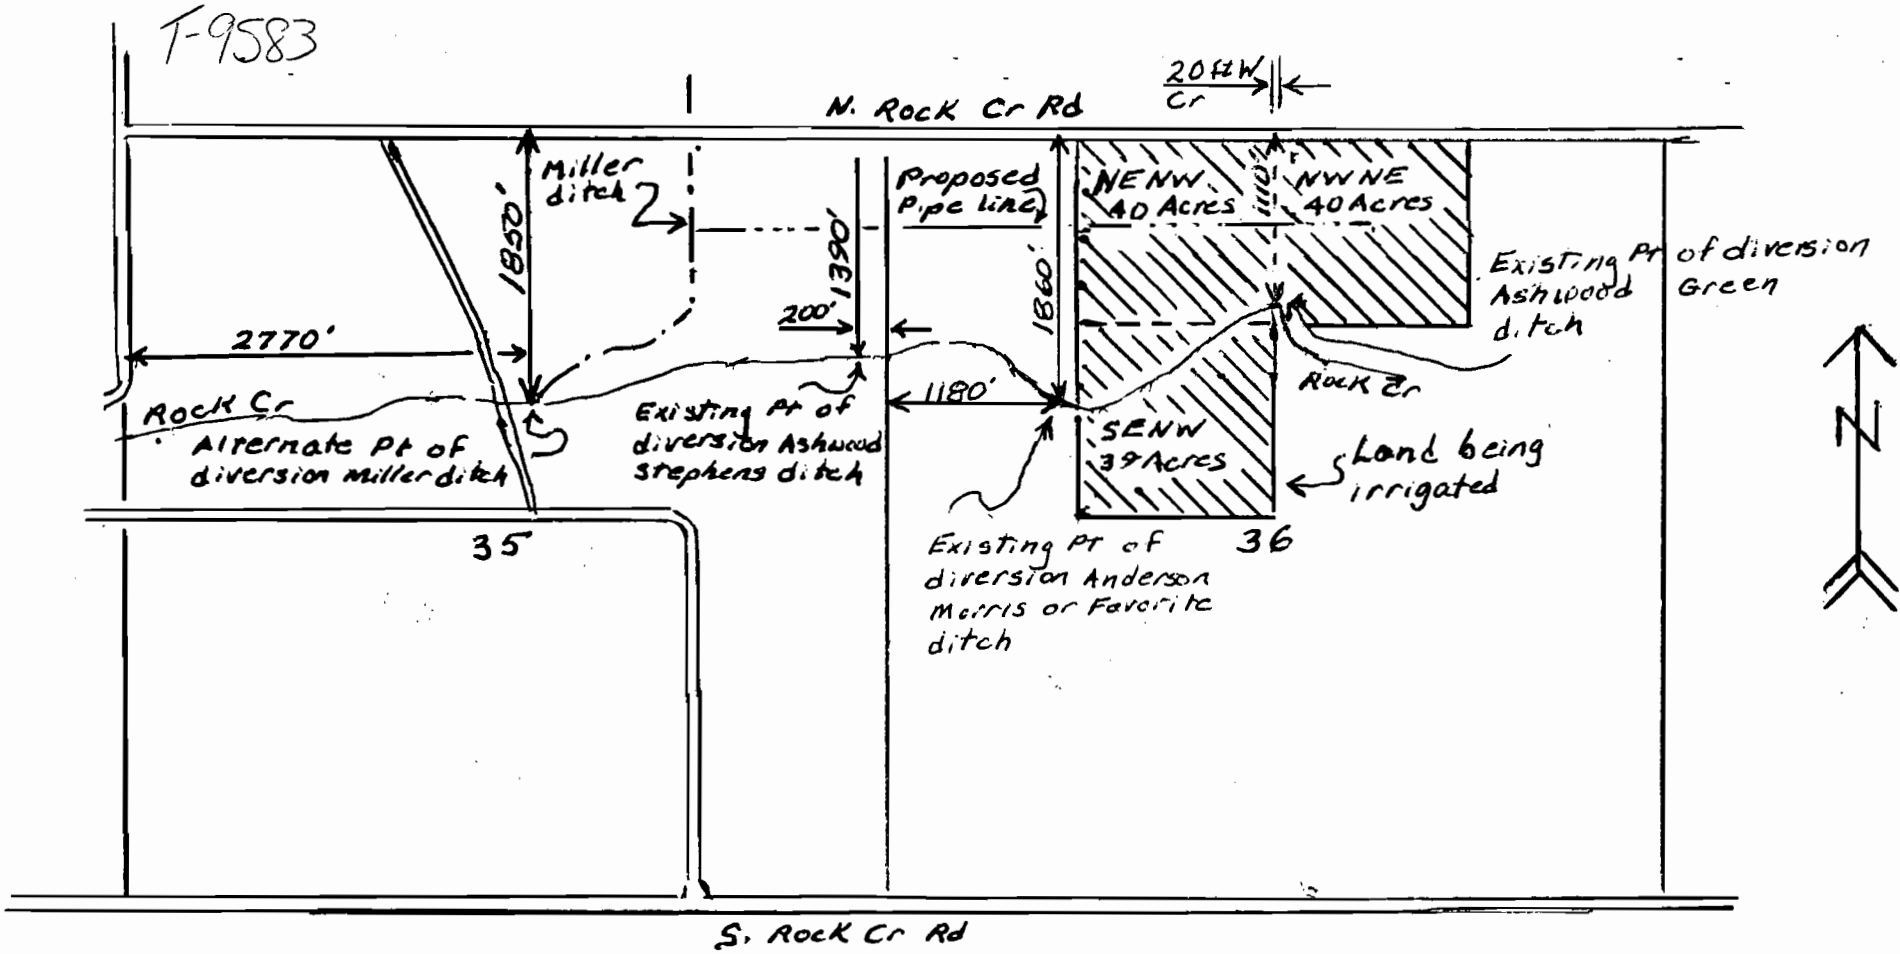

The preparation of this map was to identify the proposed alternate point of diversion for C 3977 and has no intent to provide dimensions or location of property ownership lines. Location information shown here was provided by the applicant


Certified Water Right Examiner #278 Tom Mac Kerns May 30, 1991 STATE OF OREGON

Scale 1 inch = 1320 feet Drawn 9-29-03 TMK Revised 4-2-04 TMK

RECEIVED  
 APR 02 2004  
 WATER RESOURCE DEPT.  
 EASTERN REGION

PROPOSED ALTERNATE POINT OF  
 DIVERSION AND PLACE OF USE CHANGE  
 C 3977  
 T.7S.; R.30E.; W.M.

RECEIVED  
 FEB 09 2005  
 WATER RESOURCE DEPT.  
 EASTERN REGION

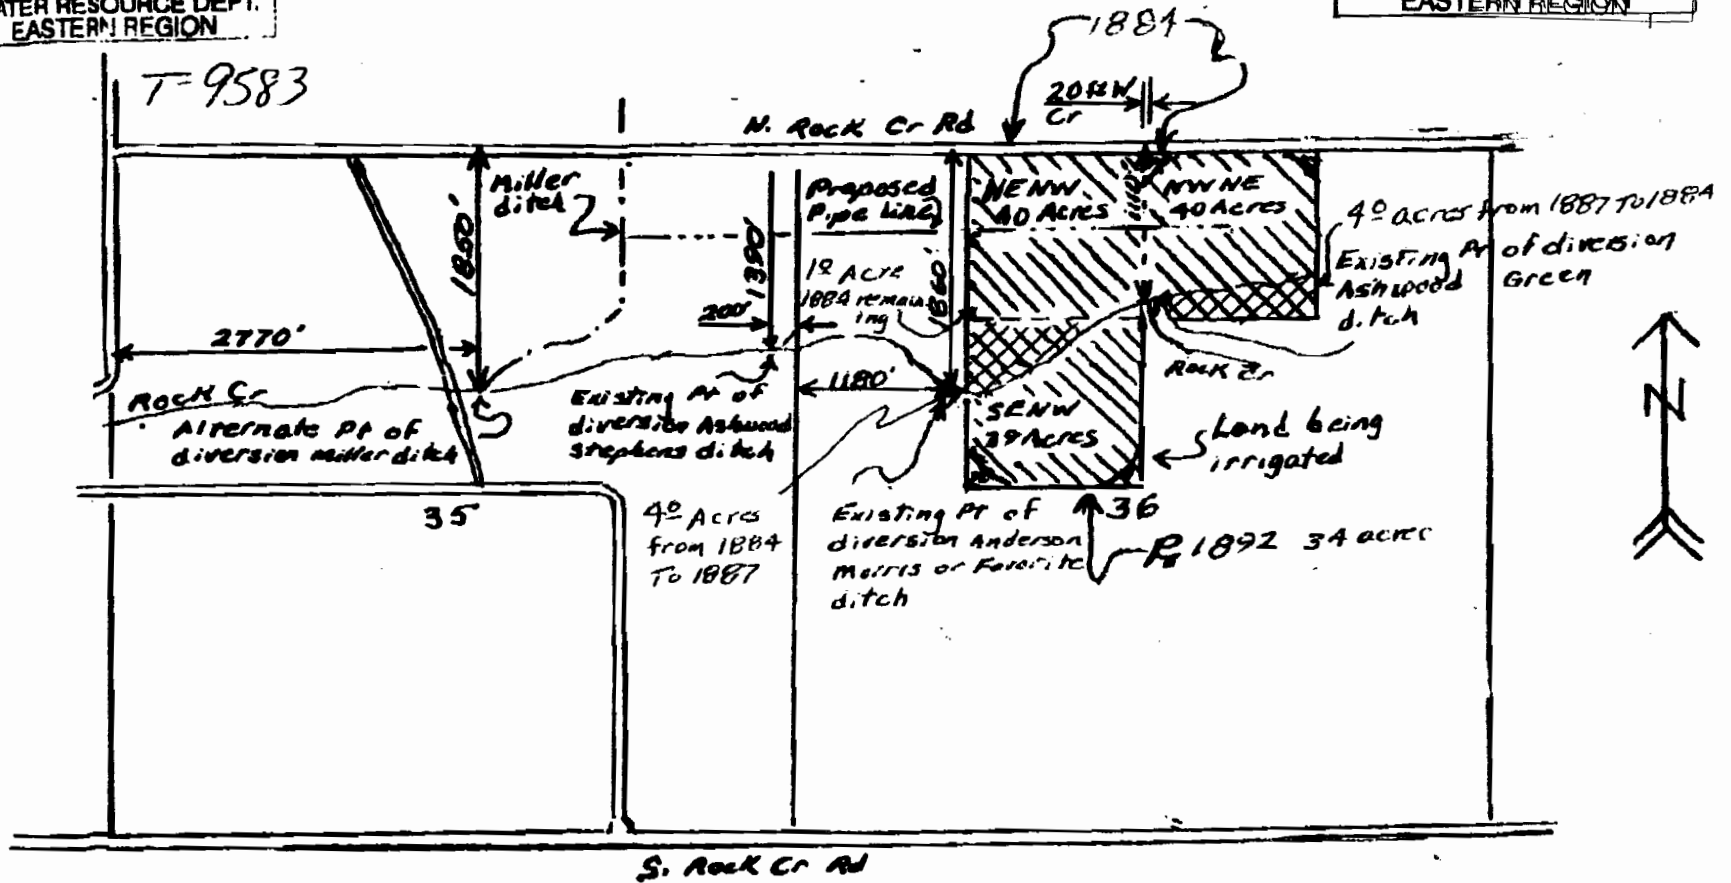

The preparation of this map was to identify the proposed alternate point of diversion for C 3977 and has no intent to provide dimensions or location of property ownership lines. Location information shown here was provided by the applicant.

Certified Water Right Examiner  
 8278  
 Tom Mac Kern  
 Tom Mac Kern  
 May 30, 1991  
 STATE OF OREGON

Scale 1 inch = 1320 Feet  
 Drawn 9-29-03 TML  
 Revised 1-2-04 TML  
 Revised 4-26-04 TML  
 Revised 2-7-05 TML  
 Revised 2-8-05 TML