


T.6N.,R.35E.,W.M.

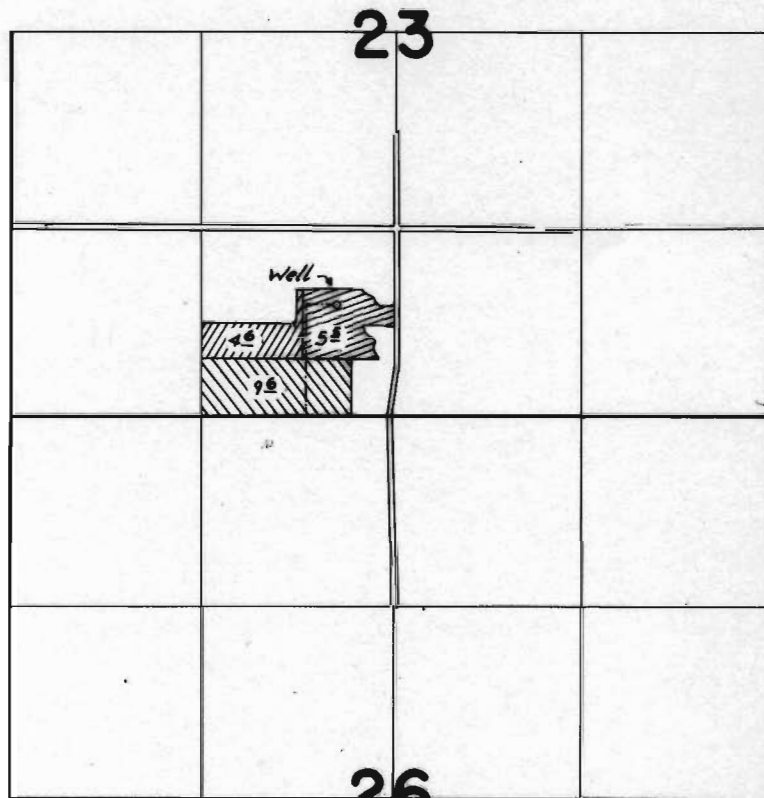

Well Loc.: 760 'N. & 2300 E. from SW Cor Sec 23

 Suppl. G-5624
 Prim. G-5624
 Prim. G-6548

FINAL PROOF SURVEY
UNDER

Application No. G-5624 Permit No. G-5460
G-6548 G-6153
IN NAME OF

Stan Pavish

Surveyed Apr. 8, 1976 by C. R. King