


T 26 S, R 30 E, WM

NORTH OF MALHEUR LAKE

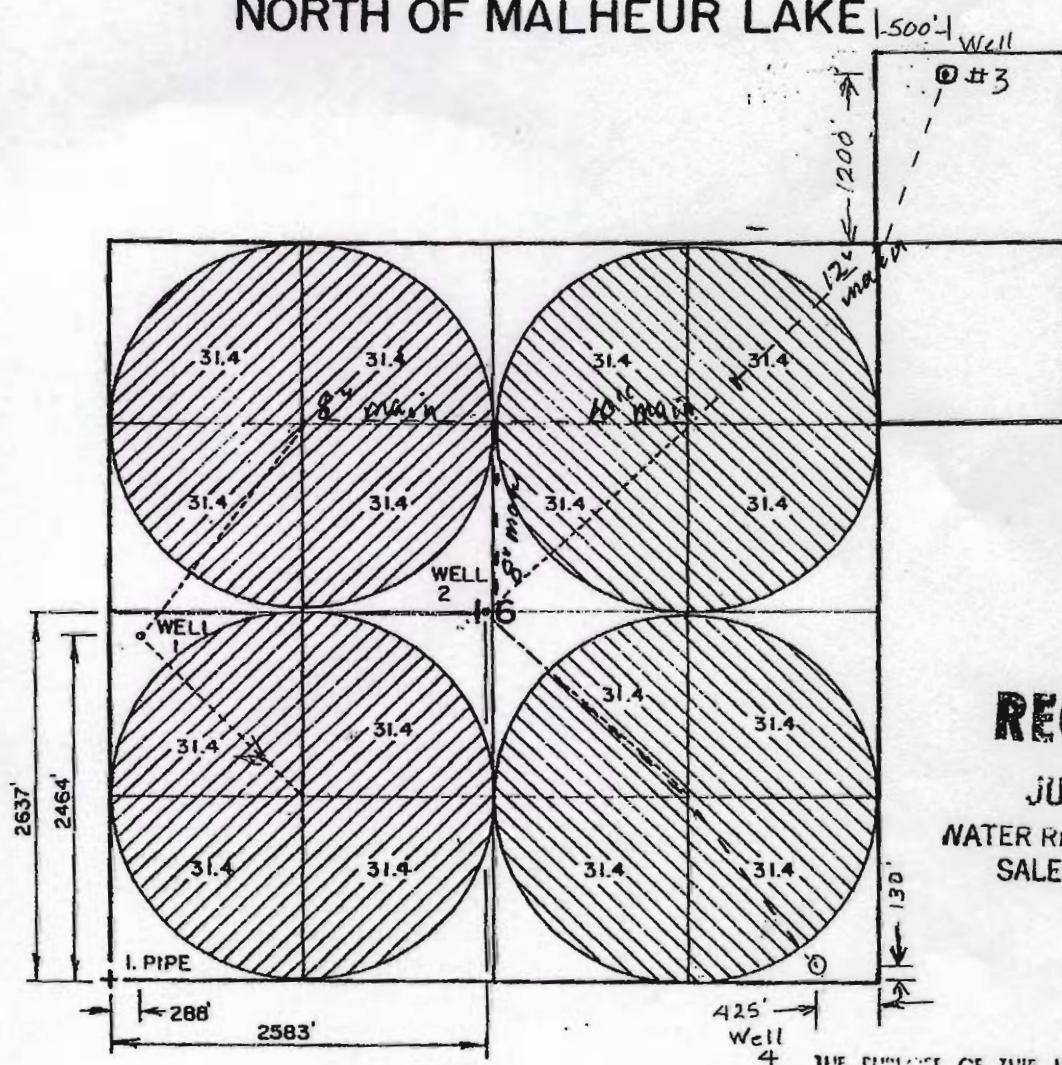

RECEIVED

JUL 20 1995

WATER RESOURCES DEPT.
SALEM, OREGON

Application No. G-14135
Permit No. G12760

THE PURPOSE OF THIS MAP IS TO
IDENTIFY THE LOCATION OF THE
WATER RIGHT. IT IS NOT INTENDED
TO BE A BASIS FOR DETERMINING
THE LOCATION OF PROPERTY
OWNERSHIP.

CHARLES C. LEATHERS, JR. Assigned To Joseph R. Buerman
WATER RIGHT APPLICATION MAP

Scale: 4" = 1 MILE

Date: APR. 1995

Job: 1569 - A

Dsn:

Drm: CHRIS

Ckd:

MAP's

M. A. PALMER & SONS, INC.
ENGINEERING & SURVEYING
254 N. Alder - Box 61
Burns, Oregon 97720

Sht. No.

of 1

RECEIVED

JAN 13 2006

WATER RESOURCES DEPT.
SALEM, OREGON

T 10068