


CLAIM OF BENEFICIAL USE MAP
 TERRY AND SUSAN BRIDWELL
 TRANSFER APPLICATION T-10075
 TOWNSHIP 15 SOUTH, RANGE 10 EAST, W.M.
 DESCHUTES COUNTY, OREGON

Peterson Ridge Rd.

23 24

26 25

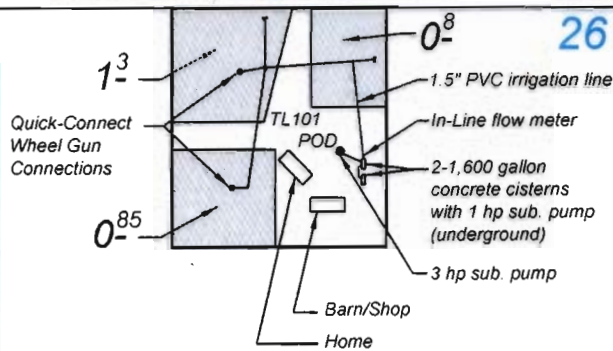

Point of Diversion (POD) Location:
 Well located 600' W & 300' S of
 NE corner of Section 26

Place of Use

RECEIVED

APR 11 2008

WATER RESOURCES DEPT
 SALEM, OREGON



EXPIRATION DATE: 06/30/08

This map is for the purpose of locating a water right only and has no intent to provide legal dimensions or the location of property lines.



1" = 400'
 SCALE

KLEINFELDER

Copyright 2008

GEOTECHNICAL AND ENVIRONMENTAL ENGINEERS
 SOILS AND MATERIALS TESTING

CLAIM OF BENEFICIAL USE MAP
 TERRY AND SUSAN BRIDWELL
 16751 PETERSON RIDGE ROAD
 SISTERS, OREGON

PROJECT # 86214 (A01)

FIGURE 1