

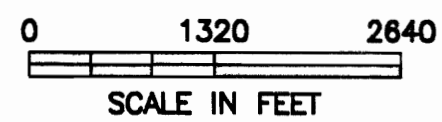
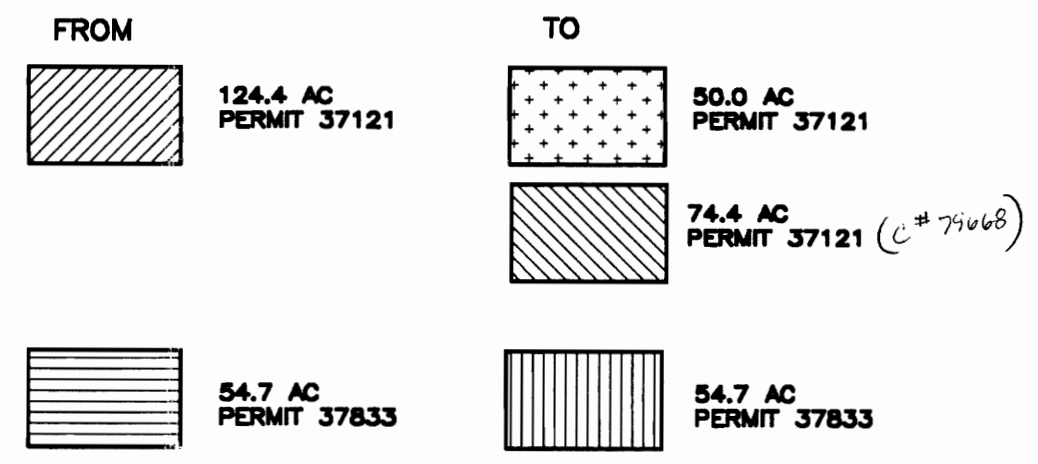
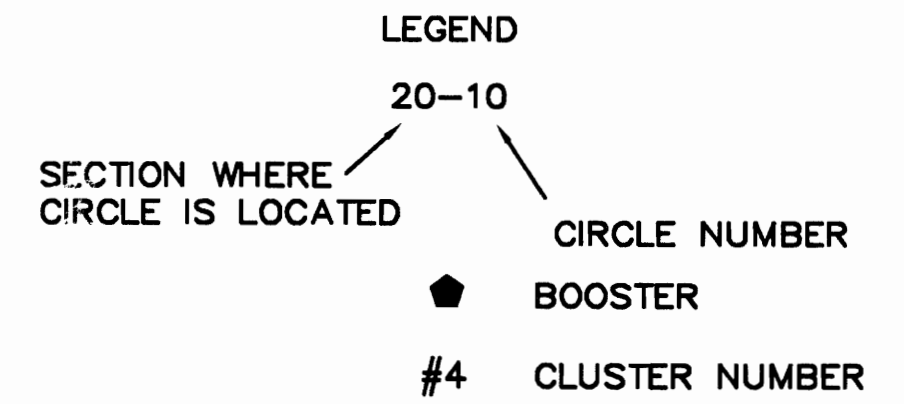


**STANFIELD HUTTERIAN
WATER RIGHT TRANSFER APPLICATION MAP FOR
PERMIT 37121, CERT 79668 AND
PERMIT 37833, CERT 73977
T4N, R30E WM**

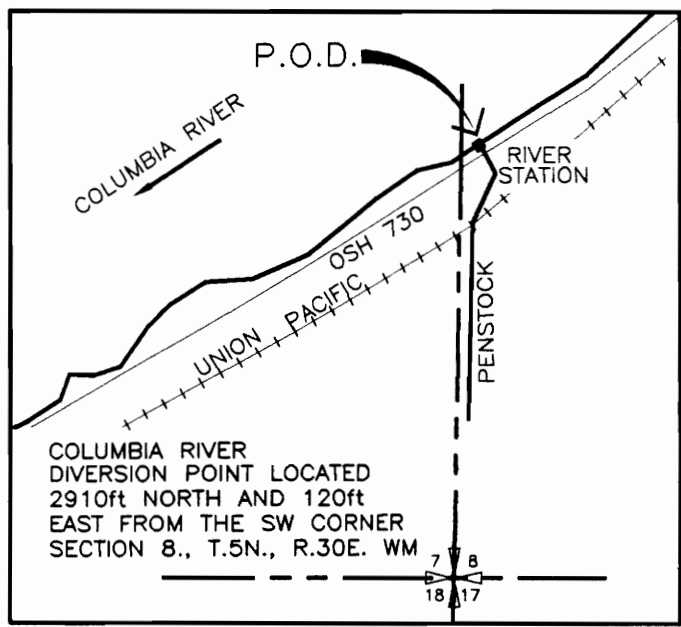

R. 29E.
R. 30E.

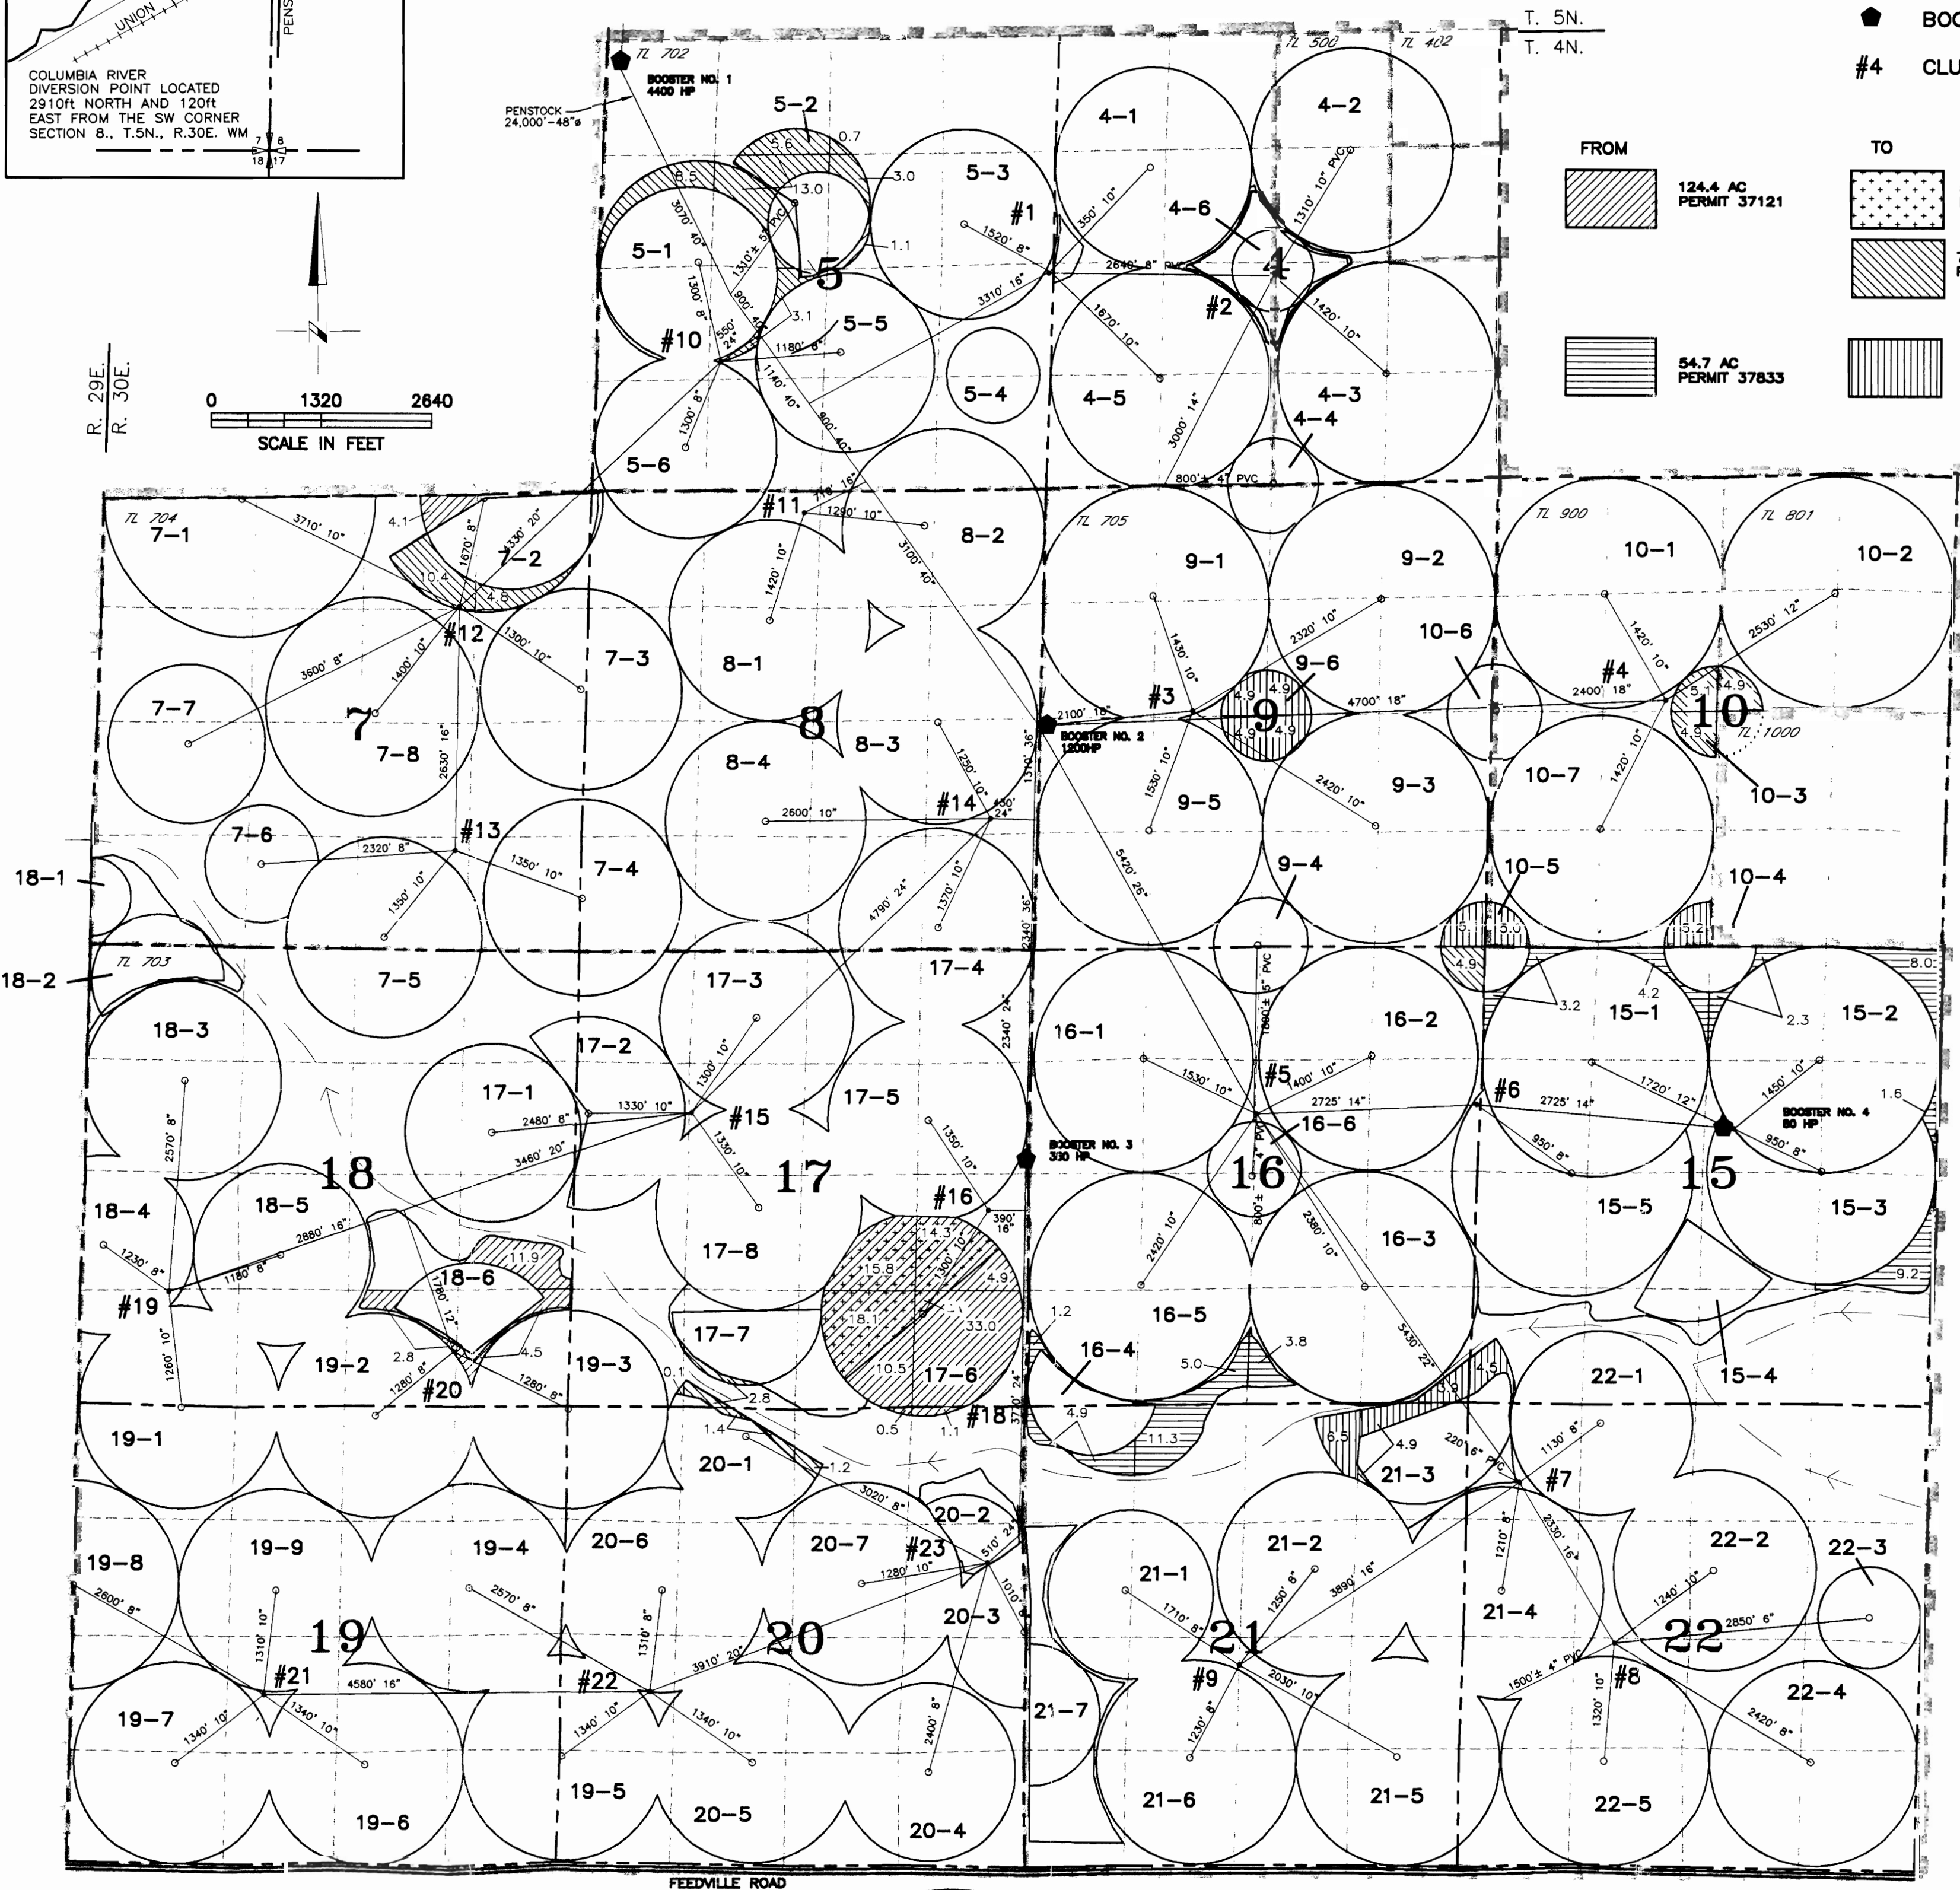

NOTE:
THIS MAP IS FOR THE PURPOSE OF IDENTIFYING THE LOCATION OF THE CENTER PIVOTS ONLY AND IS NOT INTENDED TO PROVIDE LEGAL DIMENSIONS OR LOCATION OF PROPERTY OWNERSHIP LINES. INFORMATION ON THIS MAP HAS BEEN PREPARED USING EXISTING MAPS AND OTHER INFORMATION MADE AVAILABLE BY THE OWNERS AND INFORMATION OBTAINED IN THE FIELD WHERE AVAILABLE.

