


Temporary Transfer Map (to)

T.11&12S., R.2W., W.M.

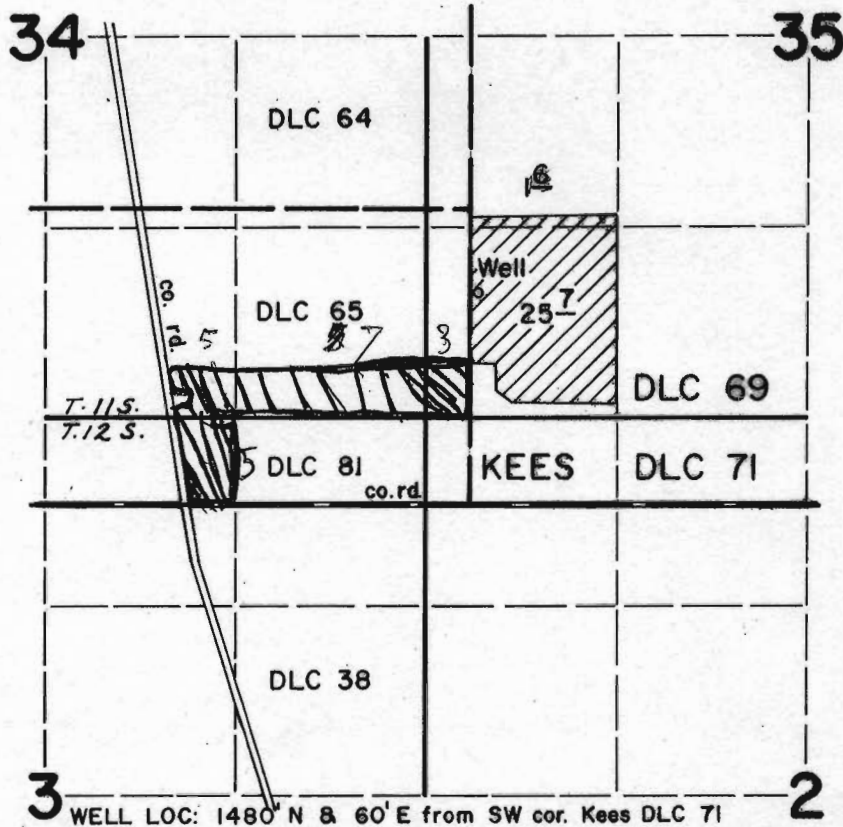

FINAL PROOF SURVEY  
UNDER

Application No. G-6763 Permit No. G-6283  
IN NAME OF

VERNON DEE CARTER

Surveyed April 14, 1976, by D. Norby

RECEIVED

MAY 09 2005

WATER RESOURCES DEPT  
SALEM, OREGON

RECEIVED

APR 04 2006

WATER RESOURCES DEPT  
T 10127

RECEIVED

COUNTY CLERK

F9925

DFM-3LL-73