
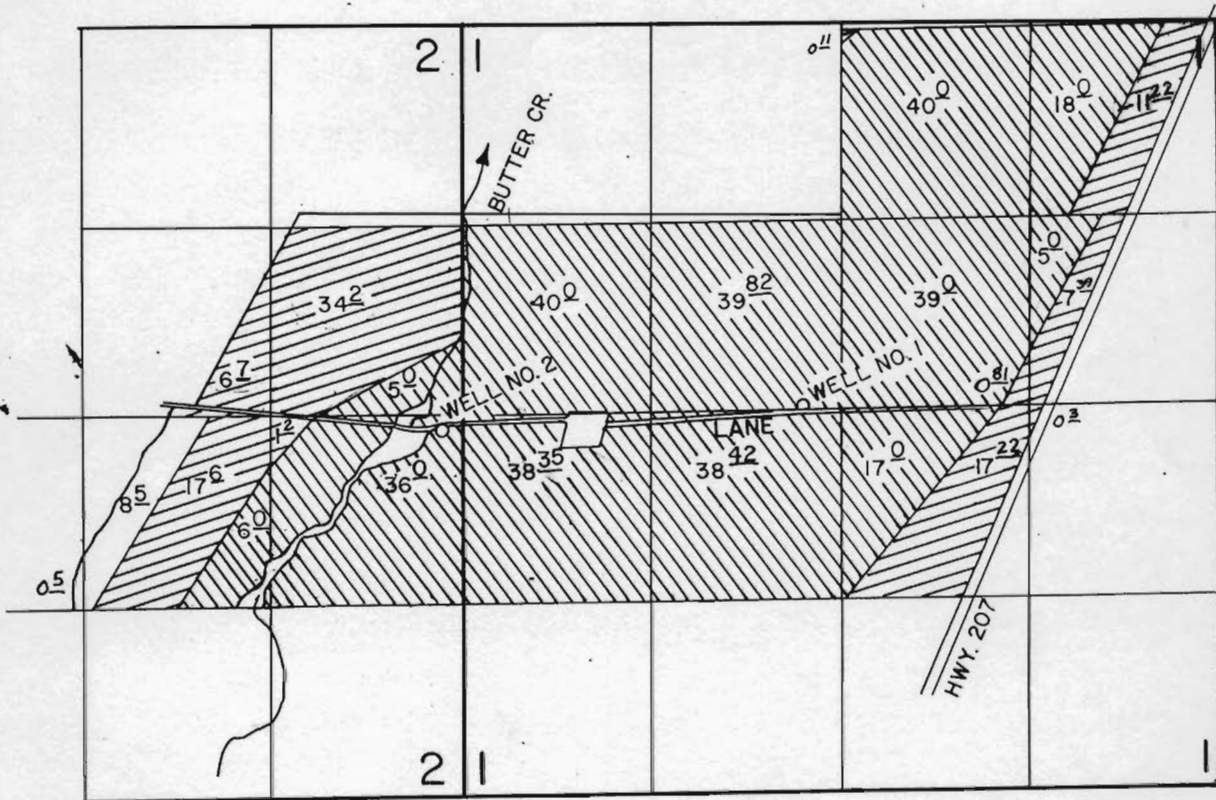
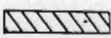


T. 2N., R. 27E., W.M.

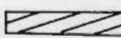

FINAL PROOF SURVEY UNDER

SUPPLEMENTAL  PRIMARY 

Application No. G-547 Permit No. G-434
IN NAME OF

CLAUSIE H., SHELIA, EDWARD N., & ALICE AMMON

Surveyed JULY 21, 1960, by R. H. JACKSON.