



T. 8 S., R. 39 E., W.M.

"FROM" LANDS

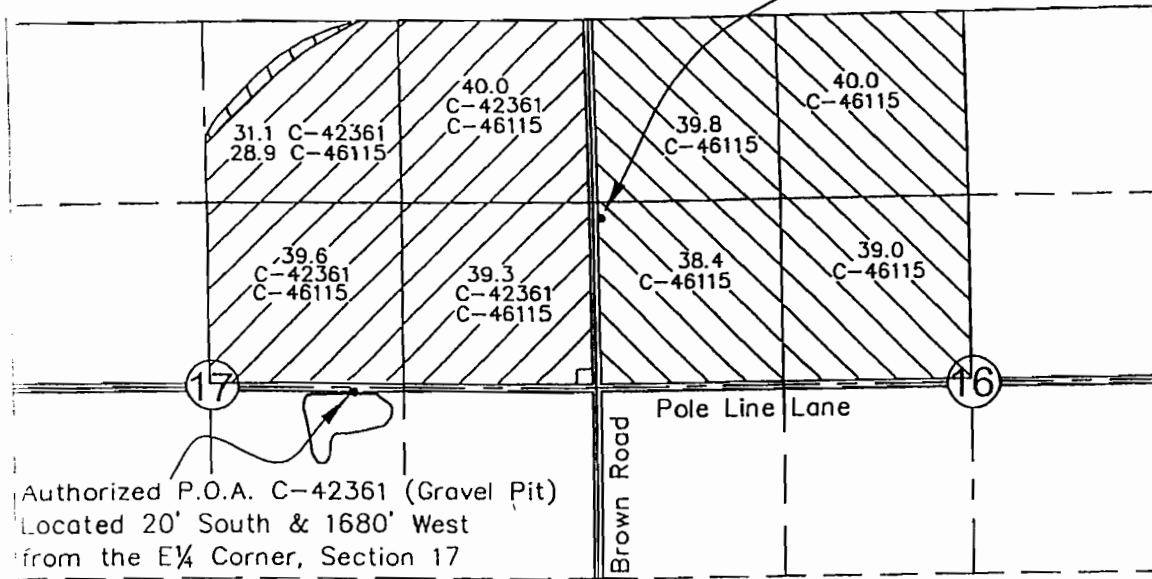

"TO" LANDS

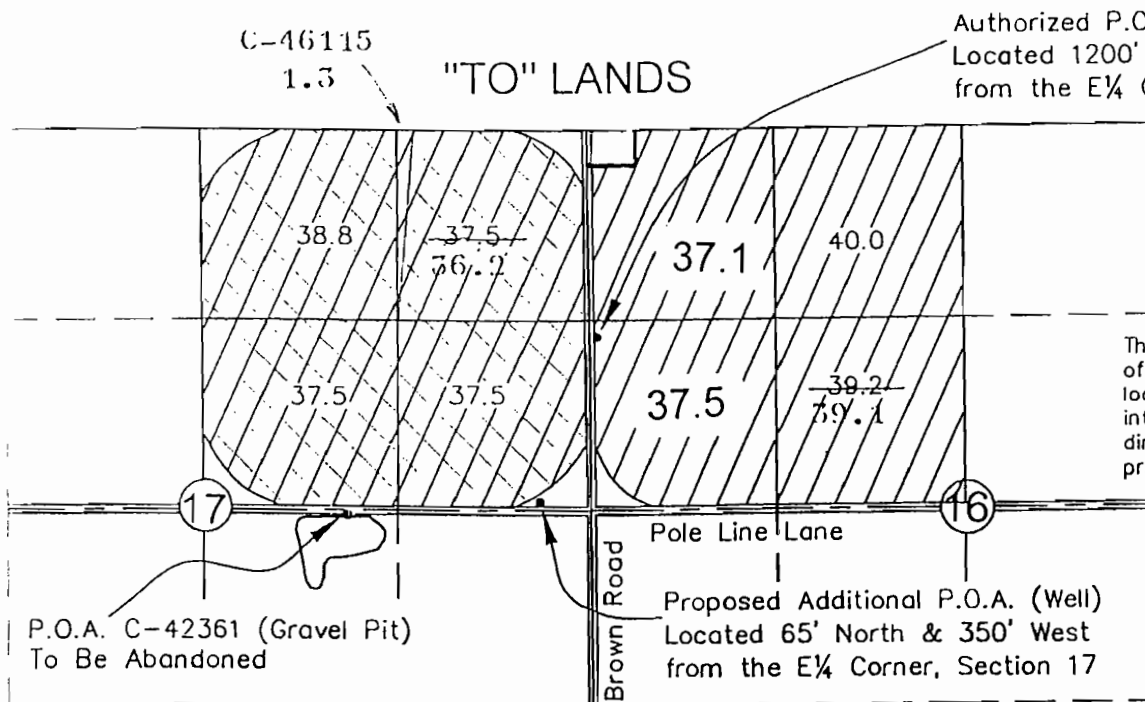


RECEIVED

JUN 22 2007

WATER RESOURCE DEPT.
EASTERN REGION

This map is for the purpose
of identifying the water right
location only and is not
intended to provide legal
dimensions or location of
property ownership lines.

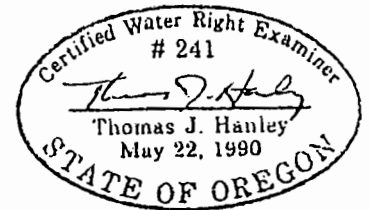

LEGEND

- Transfer "From" Lands C-42361 & C-46115
- Transfer "From" Lands C-46115
- Transfer "From" Lands C-42361
- Proposed Transfer "To" Lands" C-46115
- Proposed Transfer "To" Lands C-46115 & C-42361

MAP TO ACCOMPANY
APPLICATION FOR
WATER RIGHT TRANSFER
FOR ADDITIONAL P.O.A. & P.O.U.
In Name of
JAMES A. BLATCHFORD
Reference: C 42361 & C 46115

~~March, 2006~~

June, 2007