






T-8502

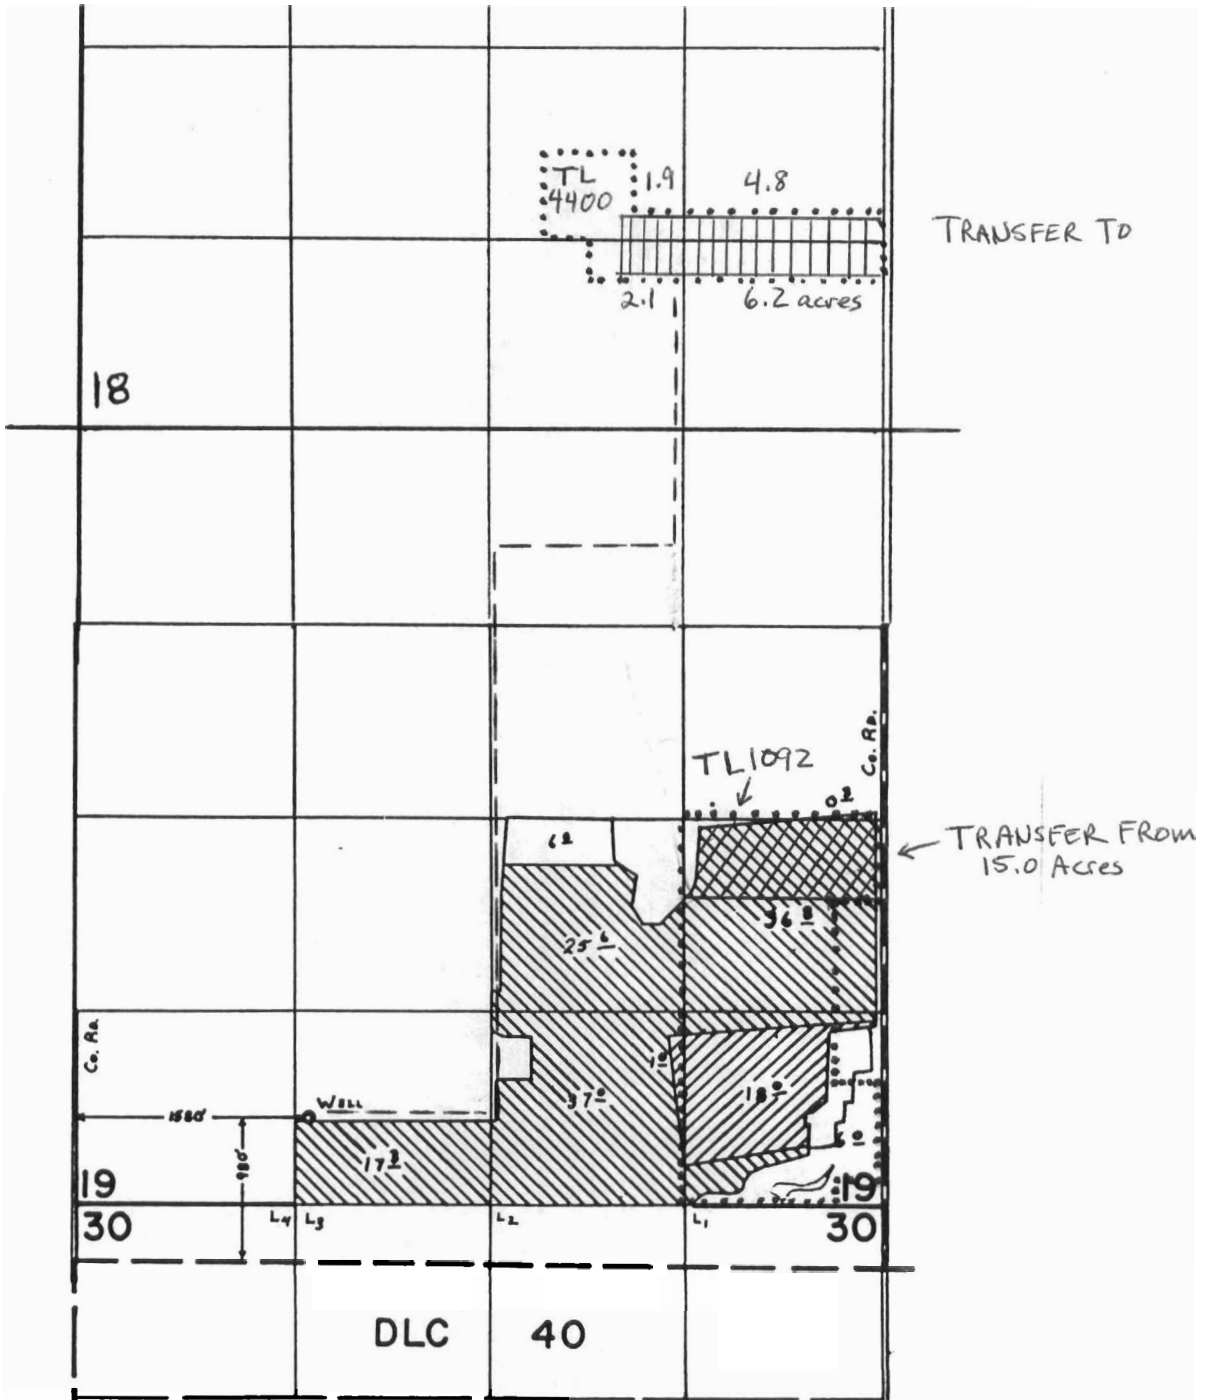

-  - PRIMARY IRRIGATION FROM WELL
 -  - SUPPLEMENTAL IRRIGATION FROM WELL
 -  - TRANSFER FROM
 -  - TRANSFER TO
 - BURIED PVC MAINLINE
 - TAX LOTS
- } EXISTING RIGHT UNDER CERTIFICATE 50656

RECEIVED

APR 21 2000

WATER RESOURCES DEPT.
SALEM, OREGON