
## T. 8 S., R. 39 E., W.M. Section 30

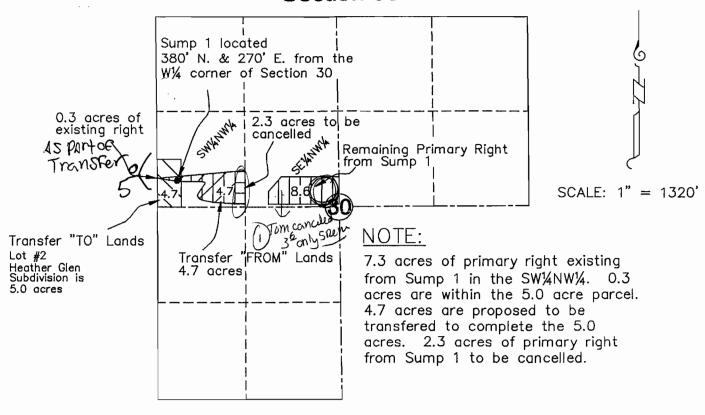

## <u>LEGEND</u>

Transfer "FROM" Lands


Transfer "TO" Lands

Existing Sump 1 Right (C #68705)

Acres to be cancelled, Cert. #68705

MAP TO ACCOMPANY
APPLICATION FOR WATER
RIGHT TRANSFER
In Name of
Carl Stiff

Reference: Cert. #68705 December, 2003 This map is for the purpose of identifying the water right location only and is not intended to provide legal dimensions or location of property ownership lines.

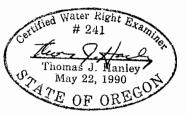

## RECEIVED

FEB 13 2004

WATER RESOURCES DEPT SALEM, OREGON

HANLEY ENGINEERING, INC. 2043 MAIN STREET BAKER CITY, OREGON

1.9651