

Expires 12/31/2001


T-851

RECEIVED

MAY 08 2000

WATER RESOURCES DEPT.
SALEM, OREGON

T. 32 + 33 South R. 6 West Willamette Meridian

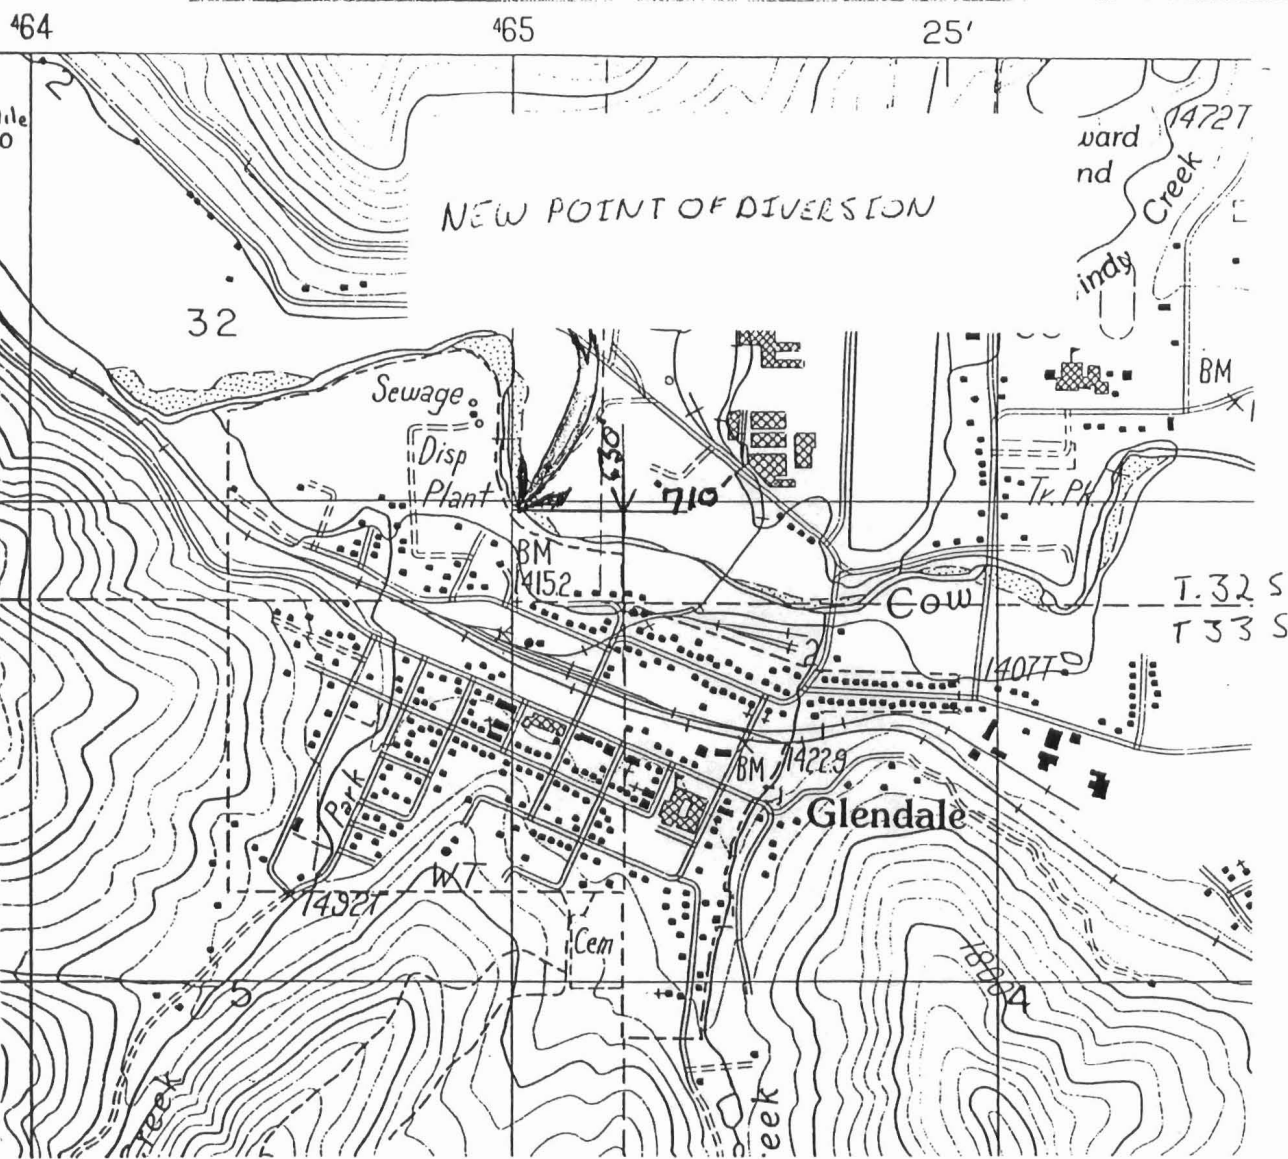

City of Glendale, Cow Creek - New Point of Diversion

Scale: 1" = 1/4 Mile = 1320'

630' N + 710' W OF NE CORNER SECTION 5