



T 40S R 9E WM  
 NW 1/4 NE 1/4 Sec. 5  
 1" = 660'


New site  
 - Well - located:  
 S 50' W 1604'  
 from NE corner Sec. 5




Old well site

Tax Lot #500


711up α  
 LEGEND:

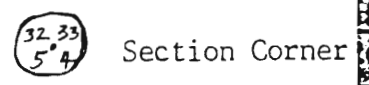


Section Corner

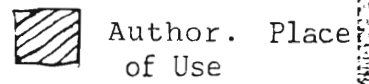


Author. Place of Use

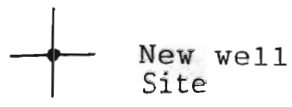

New well Site

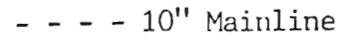


10" Mainline

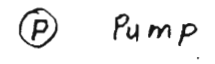

Pump

31 32

T-9652

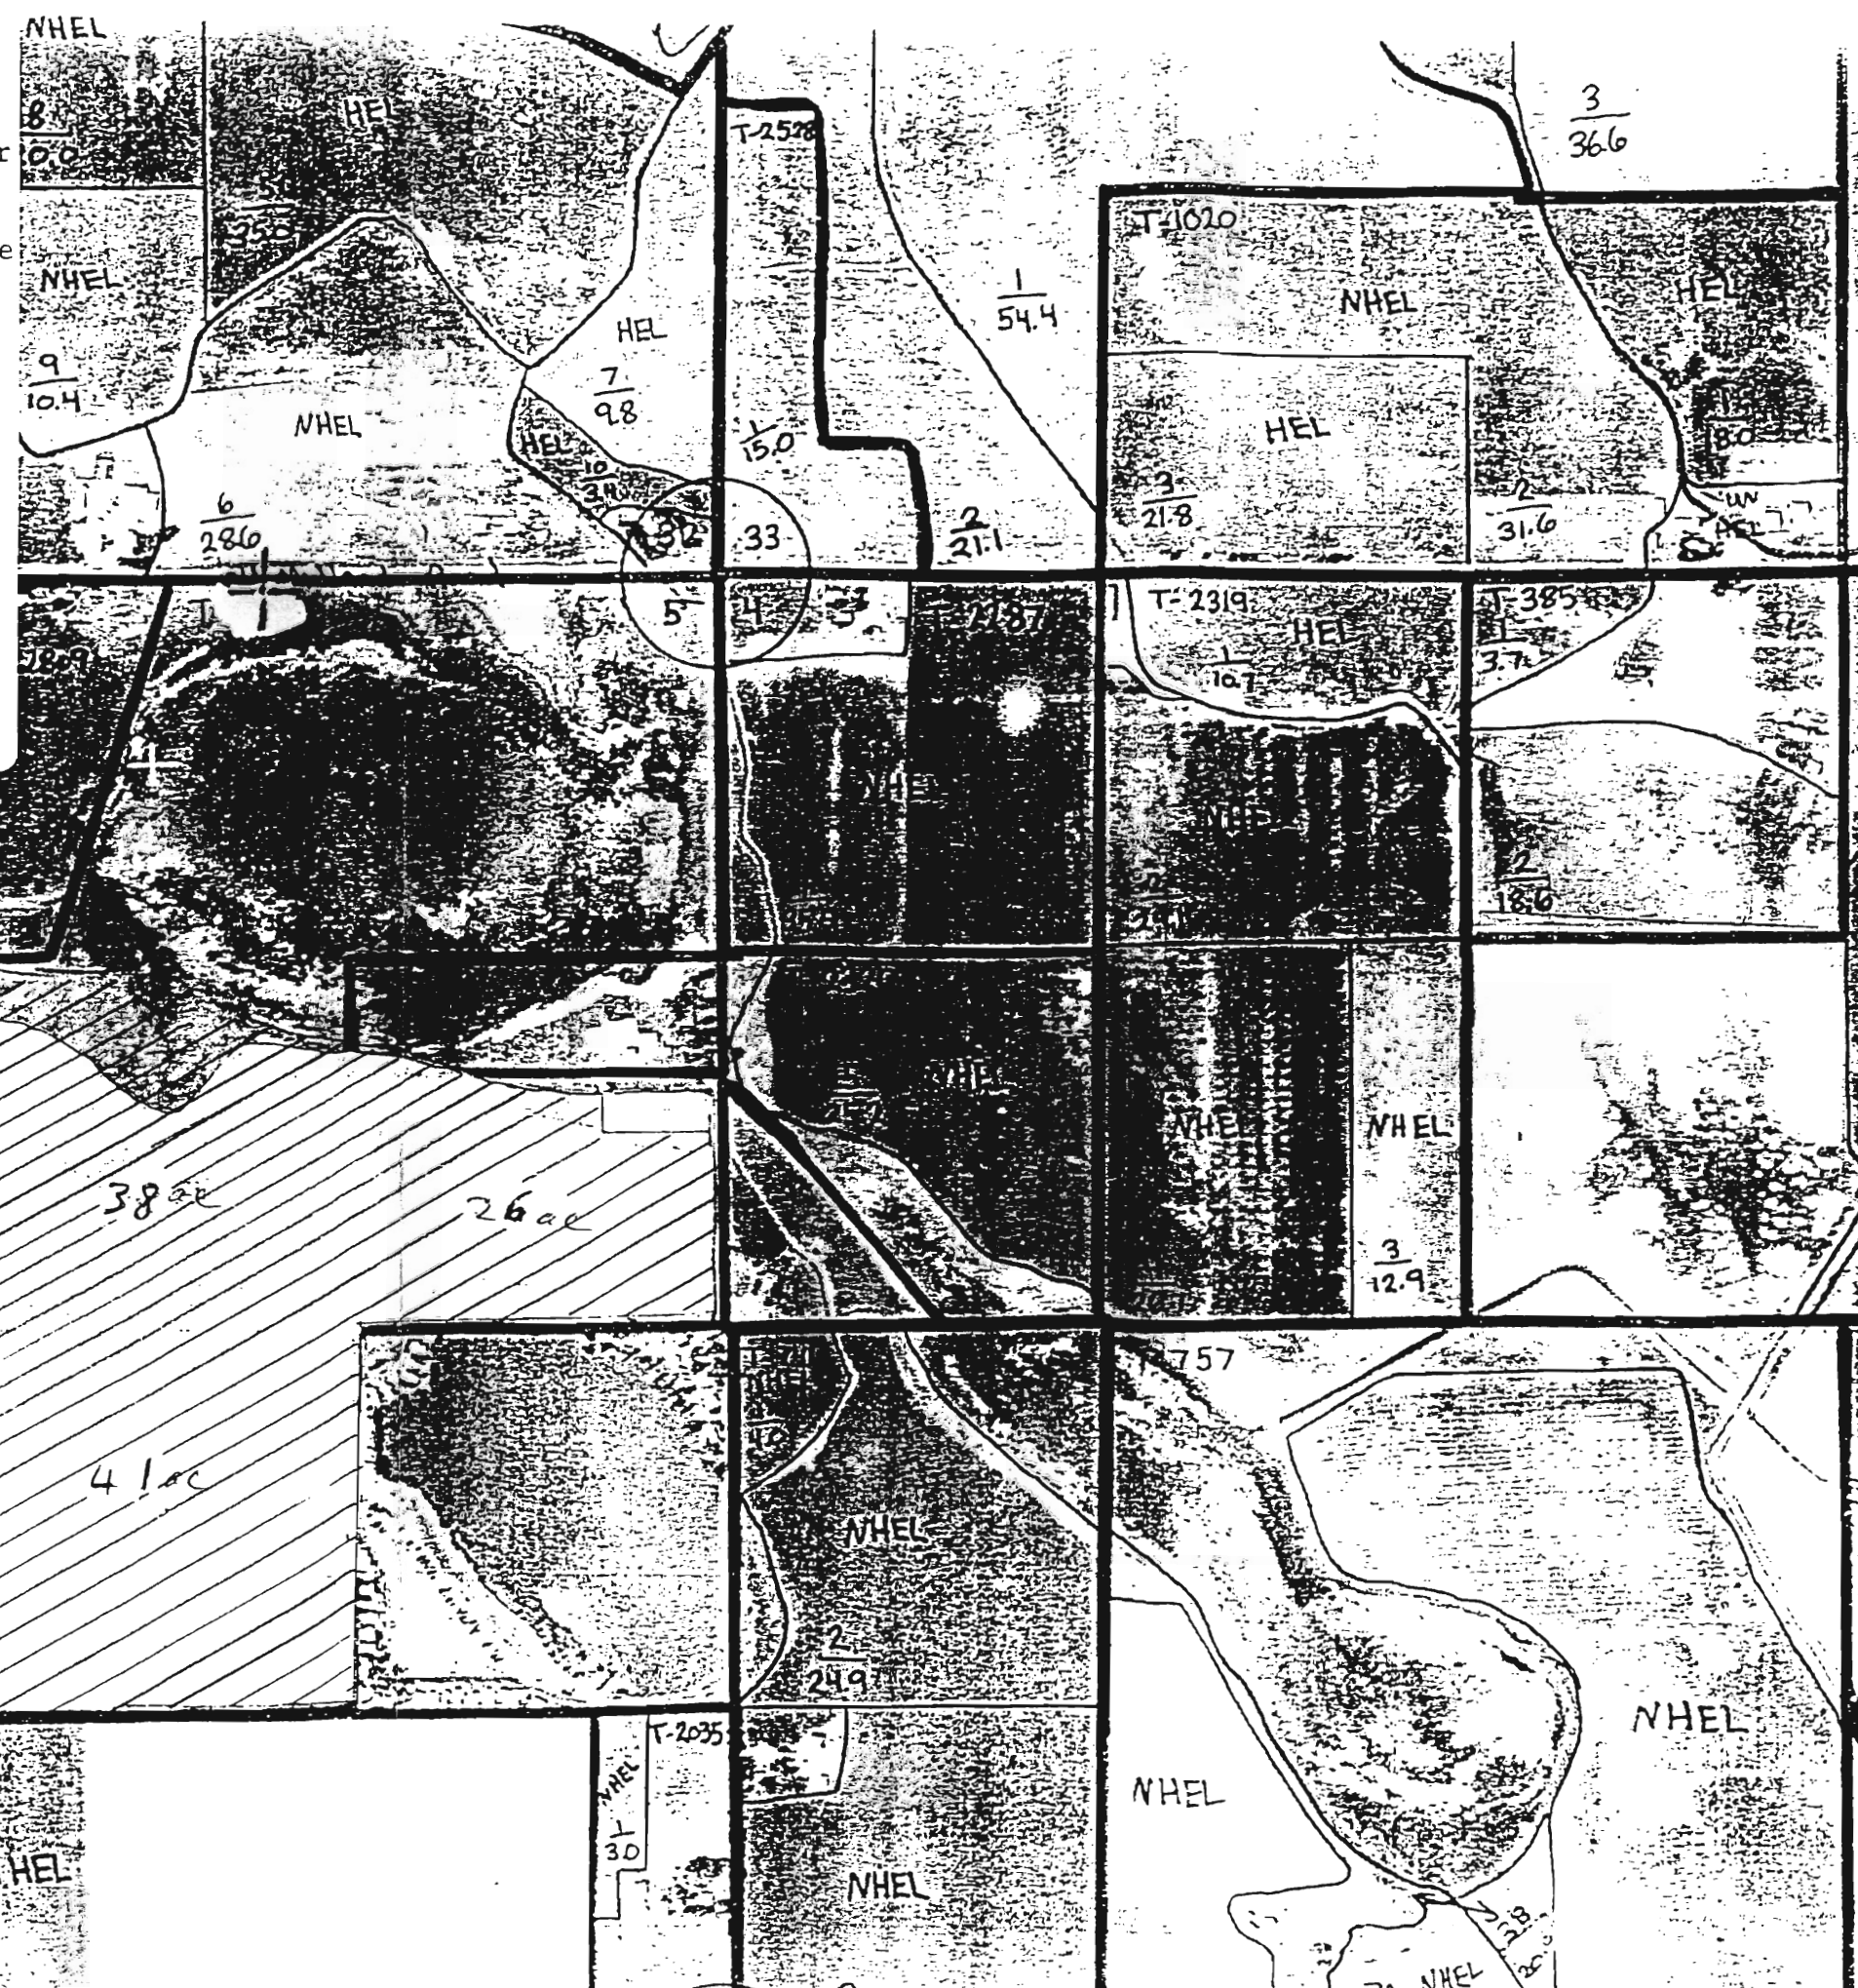

RECEIVED

3 1 2004  
 RESOURCES DEPT  
 EM, OREGON