


POINT OF DIVERSION
Scale 1" = 1320'

Authorized Point of Diversion - Houck and George Ditch, 180 feet South and 1180 feet East from West One-quarter Corner Section 8, T. 40 S., R. 7 W.

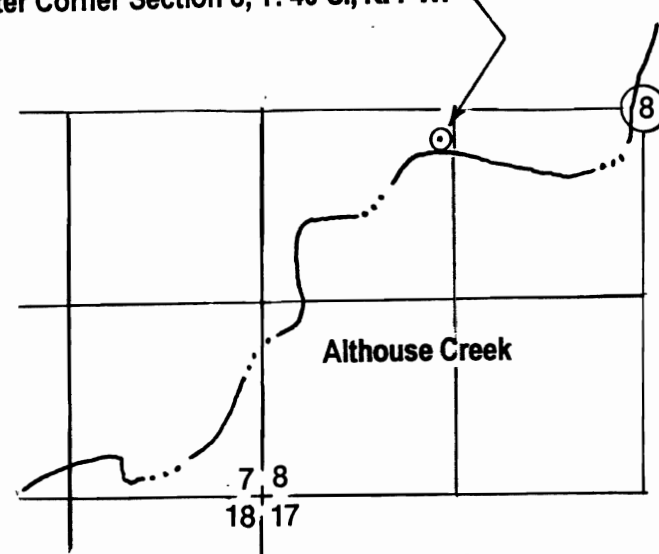


MAP OF WATER RIGHTS TRANSFER

Situated in
Sections 13 and 18, Township 40 South
Ranges 7 and 8 West, Willamette Meridian
Josephine County, Oregon
For

Wayne O. and Nancy K. Dollarhide
3199 Helms Road
Grants Pass, Oregon 97527
April 27, 2004

NOTE
Unable to identify 0.4 acre NW1/4NW1/4 Section 18 as projected Within J. Thomas DLC 37, and 0.1 acre NE1/4NE1/4 Section 13 as projected within J. Thomas DLC 45, Certificate No. 53116, Priority Date 1856.

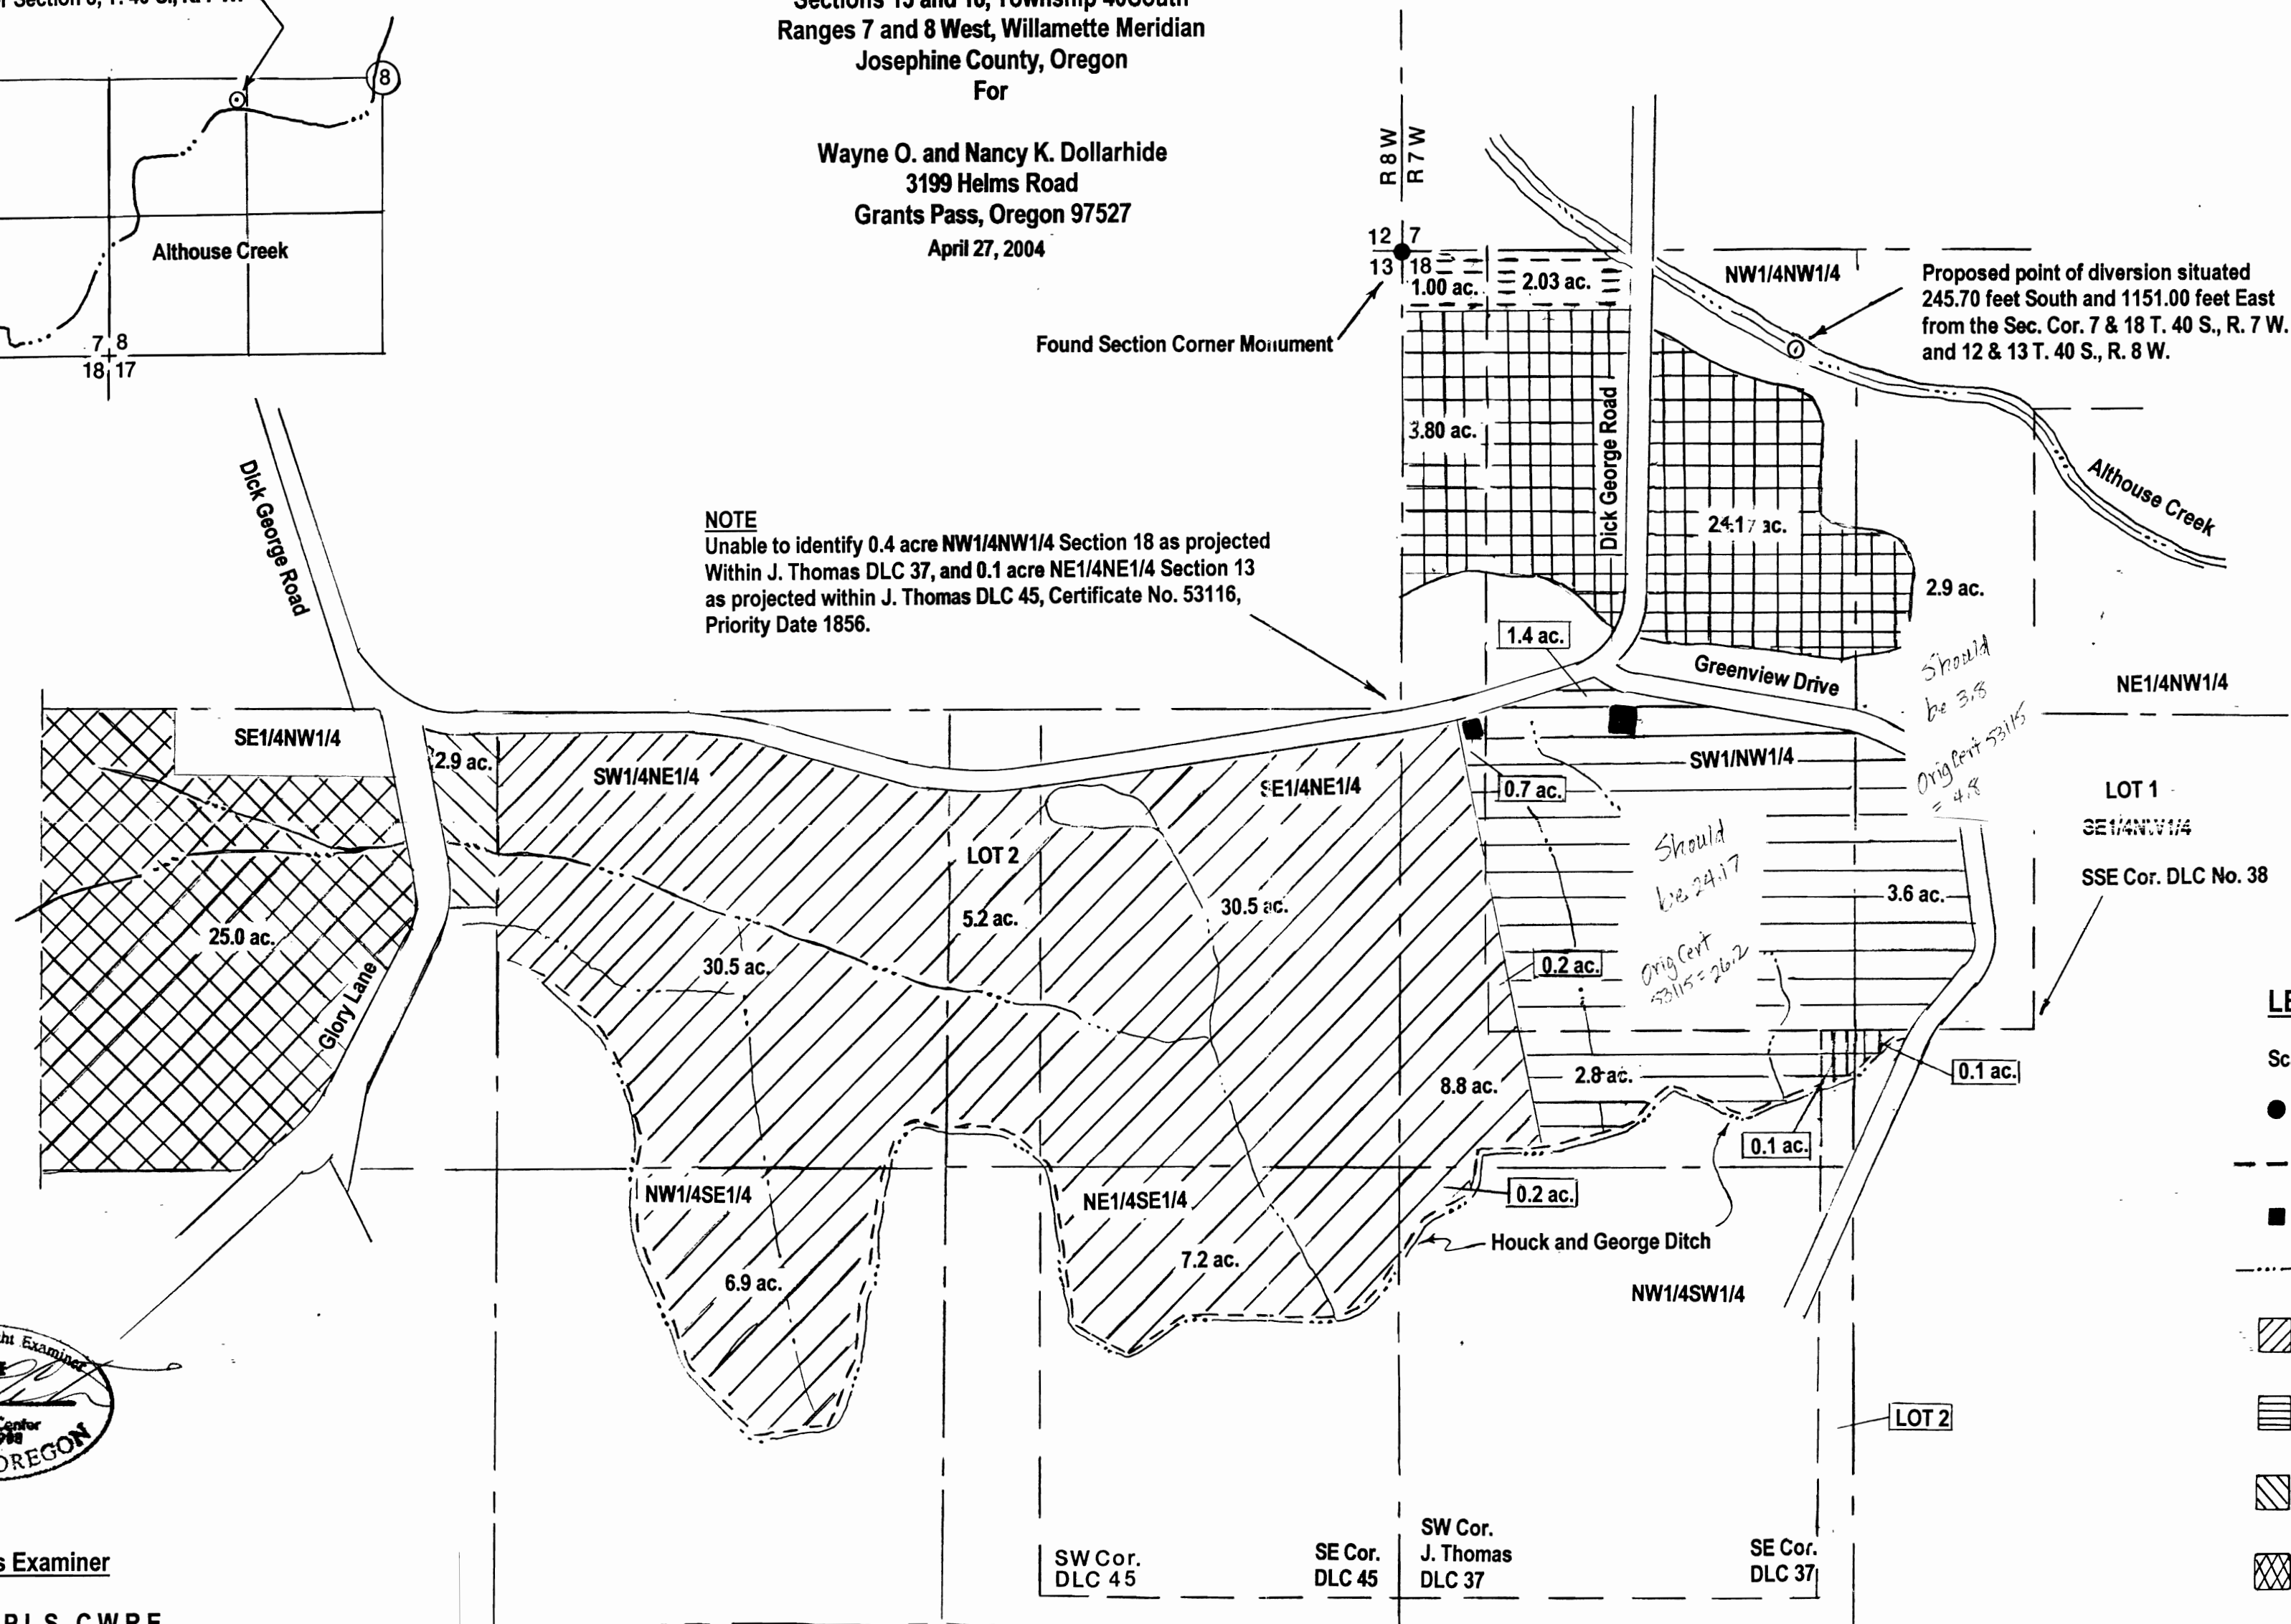



Proposed point of diversion situated 245.70 feet South and 1151.00 feet East from the Sec. Cor. 7 & 18 T. 40 S., R. 7 W. and 12 & 13 T. 40 S., R. 8 W.

*Should be 3.8
Orig cert 53116 = 4.8*

*Should be 24.17
Orig cert 53116 = 26.2*

LEGEND

- Scale 1" = 400 feet
- Found Survey Monument
- Denotes Donation Land Claim Boundary
- Denotes building or structure location
- Denotes drainage or ditch location
- ▨ Denotes area under Certificate No. 53116 Priority Date 1856.
- ▩ Denotes area under Certificate No. 53632 Priority Date 1870.
- ▧ Denotes area under Certificate No. 53632 Priority Date 1856.
- ▤ Denotes remaining right area SE1/4NW1/4 Sec. 13 Certificate No. 53632, Priority Date 1856.
- ▥ Denotes remaining right area NW1/4NW1/4 Sec. 18 Certificate No. 53632, Priority Date 1870.
- ▦ Denotes right in NW1/4NW1/4 Sec. 18 Certificate No. 74182, Priority Date 1870

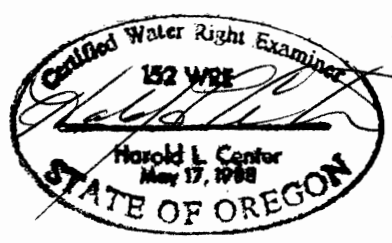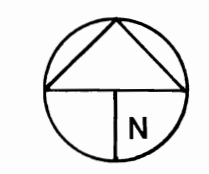

Certified Water Rights Examiner
HAROLD L. CENTER, P.L.S., C.W.R.E.
2604 David Lane - Medford, Or. 97504
541-535-6108 Fax 541-535-8752
Oregon C.W.R.E. No. 152
Certificate Renewal Date, 12/31/05

This map was prepared for the purpose of identifying the location of a water right only and is not intended to provide legal dimensions or location of property ownership lines.

*On Nov 29, 2004 Harold L. Center C.W.R.E. wrote a letter agreeing with changes made on map. Per his directions changes were made.
2-15-05
VLC*

T-9724