


T.20S, R.11E, W.M.


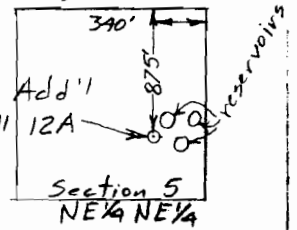


RECEIVED

MAY 19 2004

WATER RESOURCES DEPT
SALEM, OREGON

T.20S, R.11E, W.M.

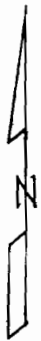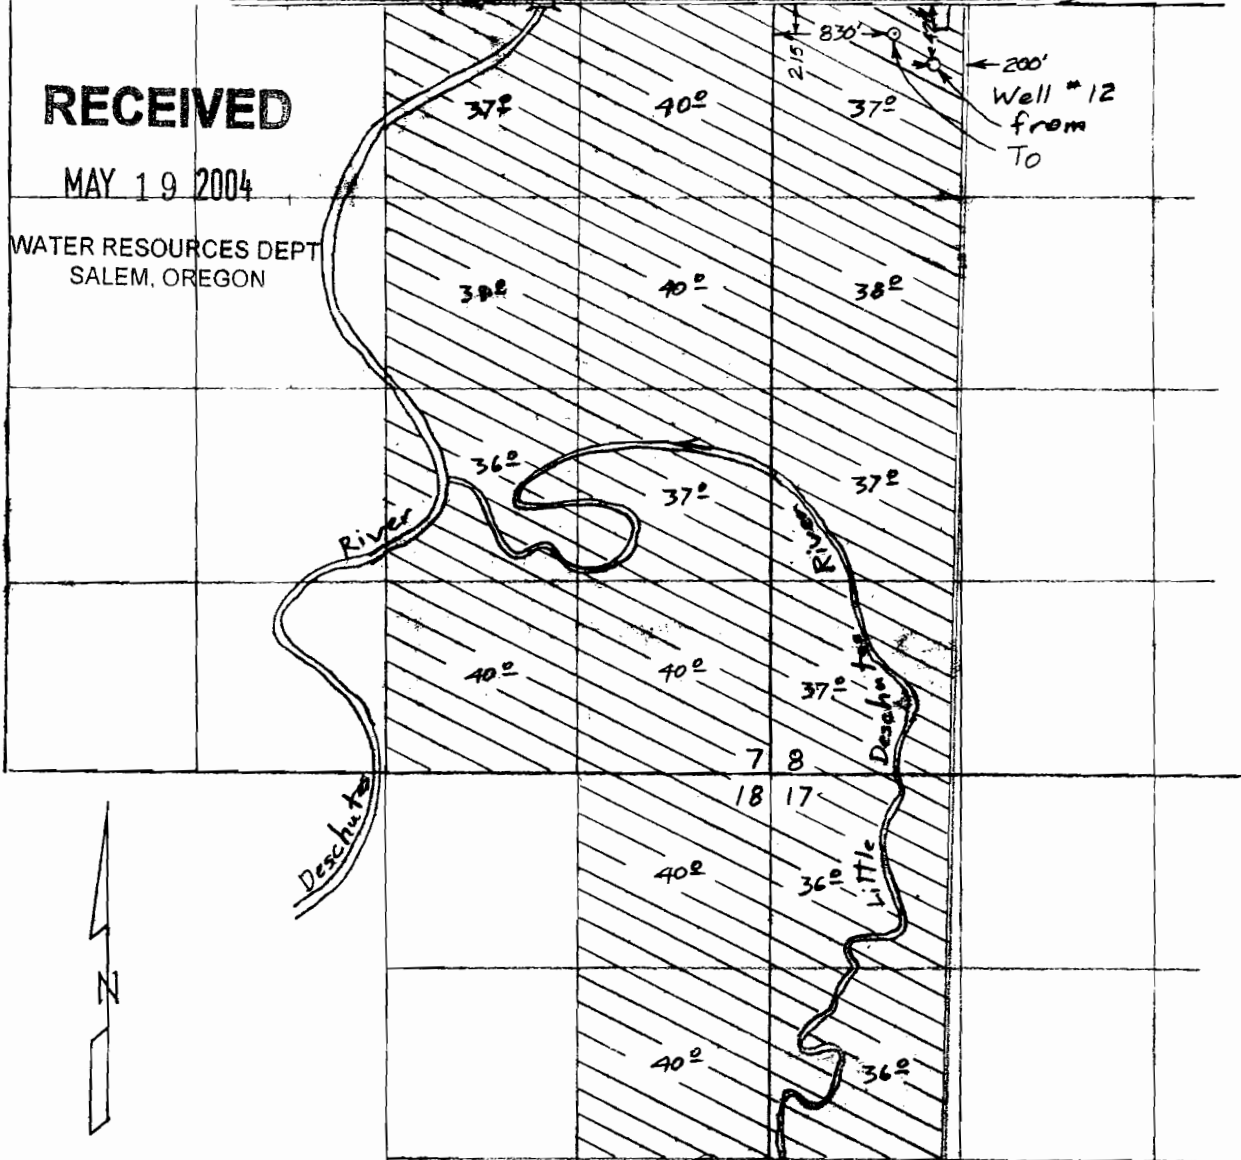


Scale 1" = 1320'

Transfer
Application Map
for


SUNRIVER WATER, LLC

App G-11627
Per G-11598
13249

T-9730

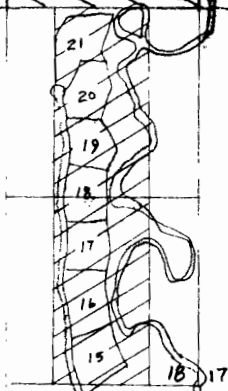

- ⊙ G-11598 Service Area
- ⊙ Amended Service Area authorized by G-13249

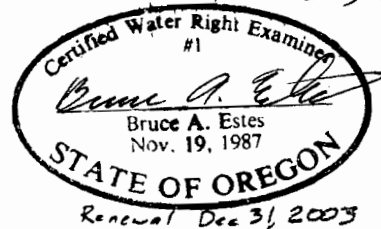

This map is for the purpose of locating a water right only and has no intent to provide legal dimensions or the location of property lines.

ESTES SURVEYS

6293 Sunnyview Rd. NE 60382 Arnold Rd.
Salem, OR 97305 Bend, OR 97702
(503) 565-7593 (503) 382-7391