

86662

RECEIVED

FEB 08 1996


WATER RESOURCES DEPT.
SALEM, OREGON

WESTERN HILLS MOBILE HOME ESTATES
John M. Malek & Ela Szuladzinski
Sections 19 & 20, T. 7N., R. 2 W., W.M.
near
Rainier, OR

RECEIVED
AUG 31 2004
WATER RESOURCES DEPT.
SALEM, OREGON

SECTION 19

SECTION 20

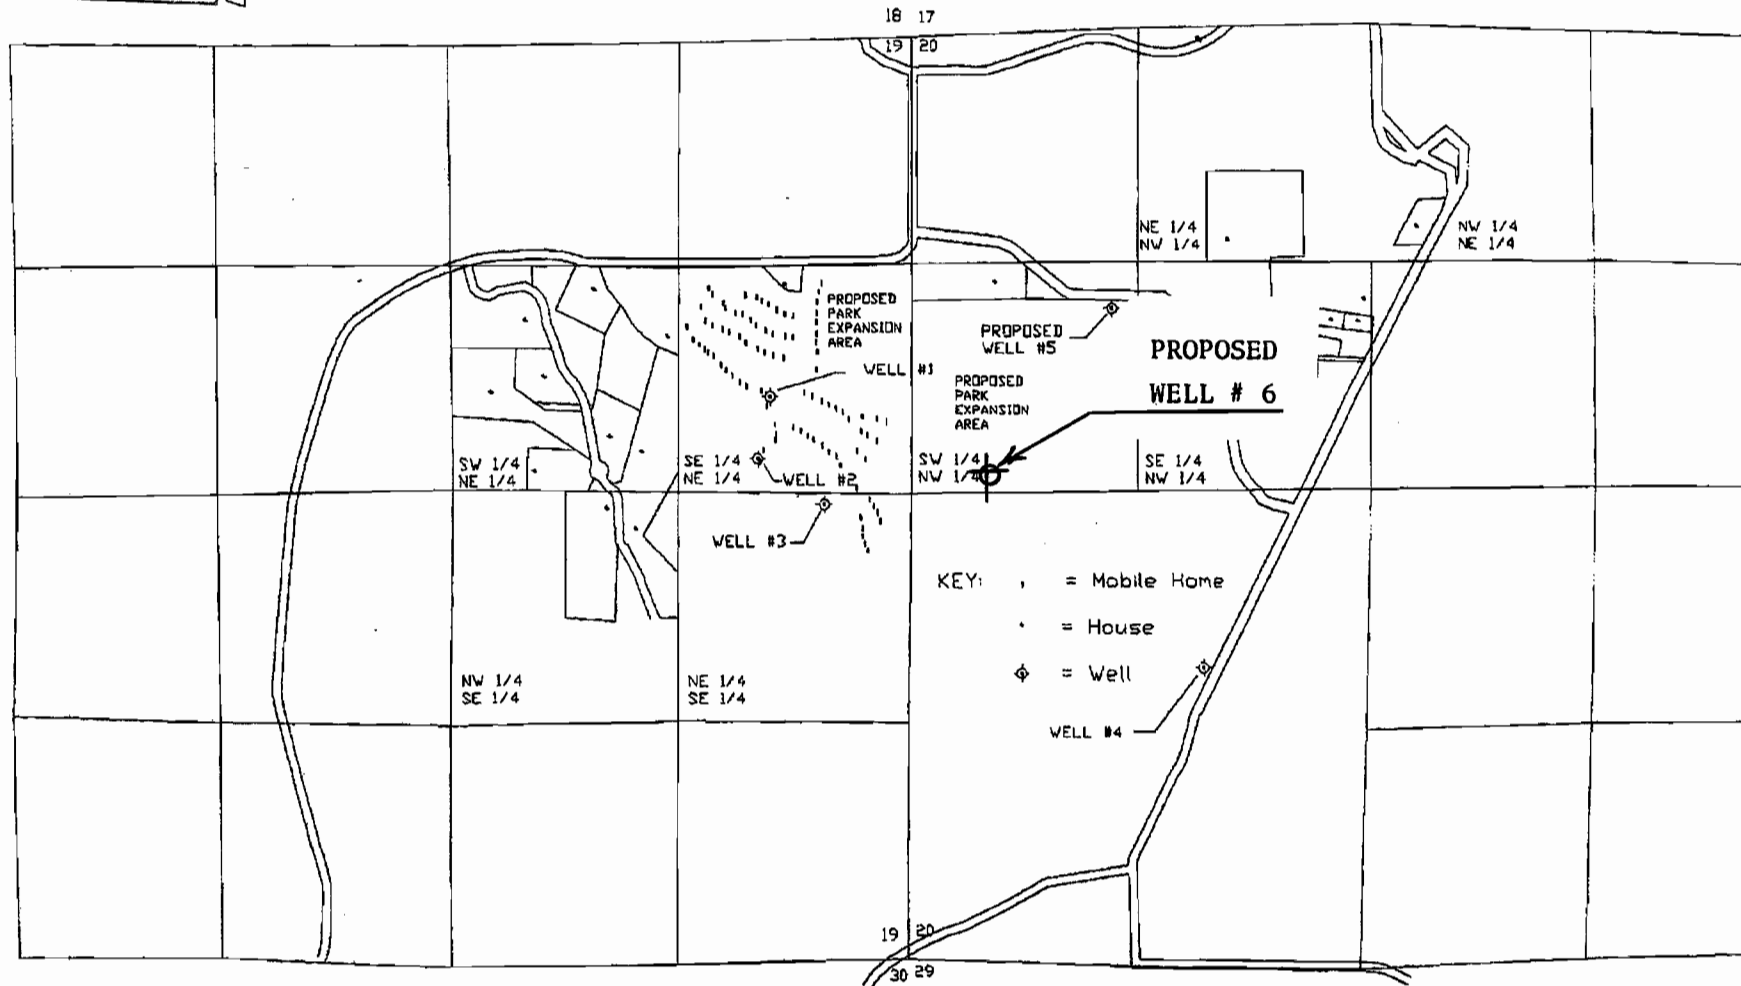

WATER RESOURCES

08/13/04 12:52 FAX 503 986 0804