

Rudd Application Map

Township 2 S Range 39 E

RECEIVED
 OCT 08 2004
 WATER RESOURCES DEPT
 SALEM, OREGON


RECEIVED
 MAY 02 2003
 WATER RESOURCES DEPT.
 SALEM, OREGON

RECEIVED
 JUN - 5 2003
 WATER RESOURCES DEPT.
 SALEM, OREGON

app NO
 G-16028
 Permit NO
 G-15541

Lat/Long
Locations

T-9802

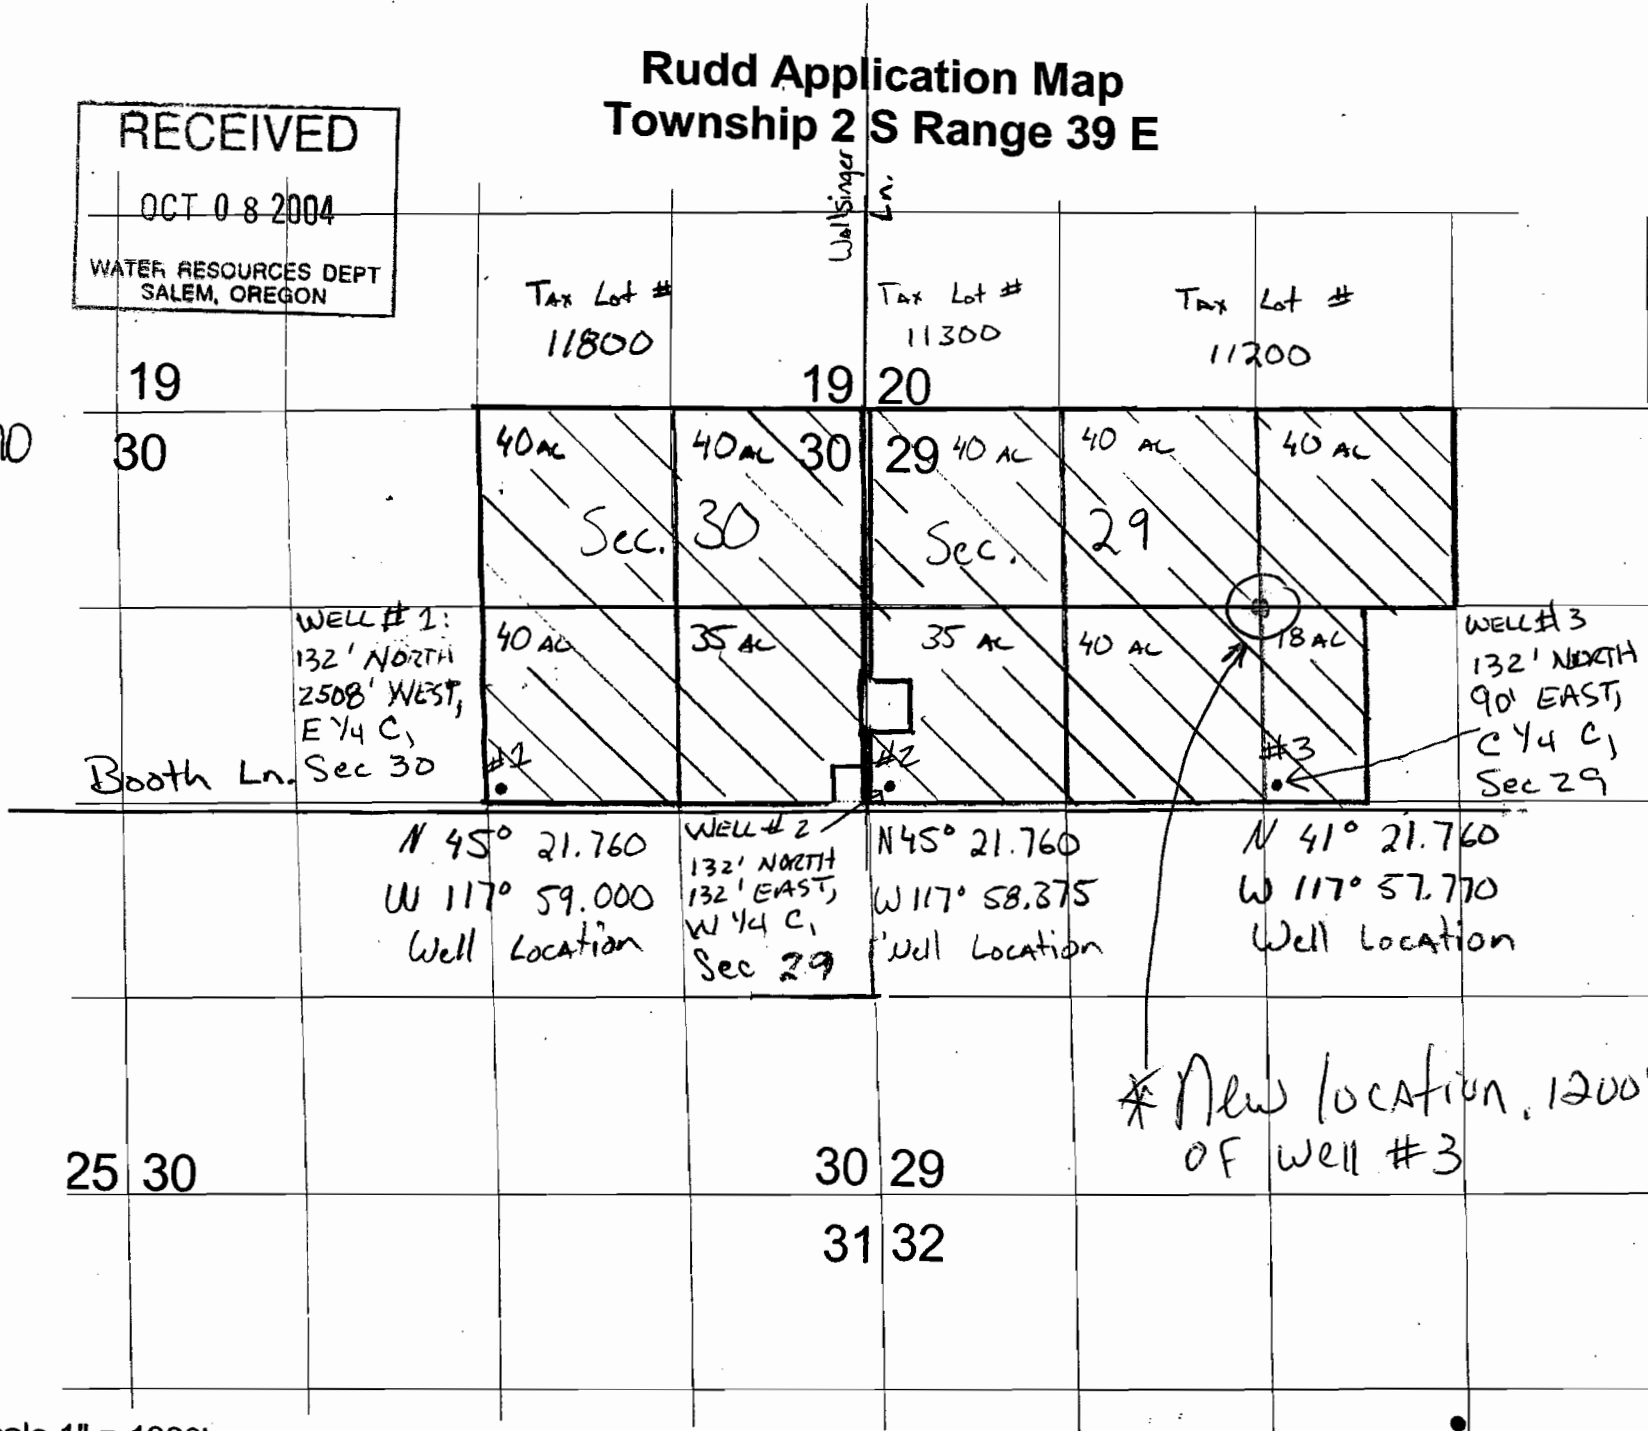

Scale 1" = 1320'

