



T.4S., R.2W., W.M

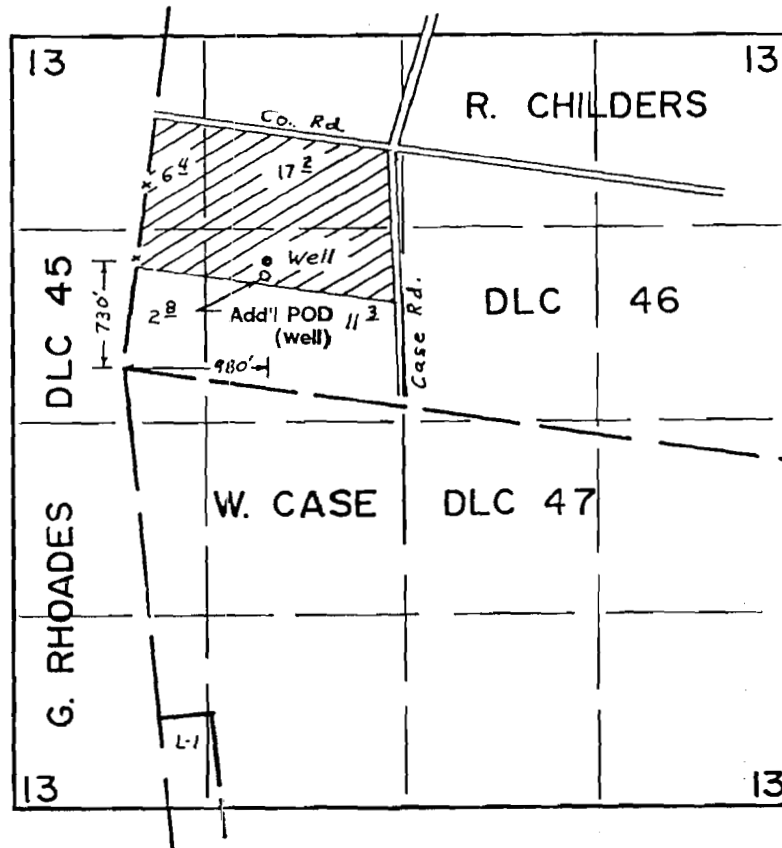

1" = 1320'

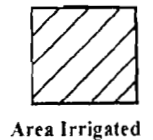


Auth. POD is located 730'N & 980'E from the SW corner of DLC 46.
Add'l POD is located 680'N & 980'E from the SW corner of DLC 46.

Application Map

Mike & Jean Ryan

Transfer #:

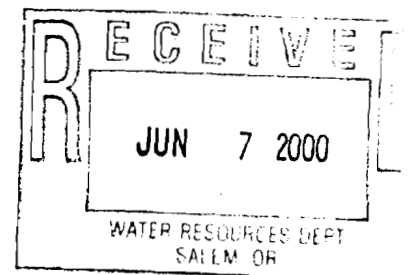

This Map Was Prepared For The Purpose Of Identifying The Location Of A Water Right Only And Is Not Intended To Provide Legal Dimensions Or Location Of Property Ownership Lines.

