

Upper Tumalo Reservoir

- T16S-R11E-SEC 32 EWM - SE $\frac{1}{4}$ SE $\frac{1}{4}$
- T16S-R11E-SEC 33 EWM - S $\frac{1}{2}$ SW $\frac{1}{4}$
- T17S -R11E-SEC 04 EWM - NE $\frac{1}{4}$ NW $\frac{1}{4}$ and W $\frac{1}{2}$ NW $\frac{1}{4}$
- T17S -R11E-SEC 05 EWM - NE $\frac{1}{4}$

THE PREPARATION OF THIS MAP IS FOR THE PURPOSE OF IDENTIFYING THE LOCATION OF THE WATER RIGHT ONLY AND HAS NO INTENT TO PROVIDE DIMENSIONS OR LOCATIONS OF PROPERTY OWNERSHIP LINES.

T-8557

RECEIVED

JUN 27 2000

WATER RESOURCES DEPT.
SALEM, OREGON

SCALE: 1" = 800'

Prepared By: Tumalo Irrigation District, 64697 Cook Ave, Bend. Oregon 97701 541-382-3053



T.16,17S.,R.11E.,W.M.

RECEIVED

OCT 05 1998

WATER RESOURCES DEPT.
SALEM, OREGON

T-8557

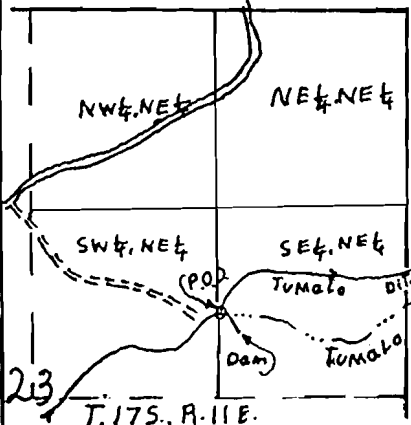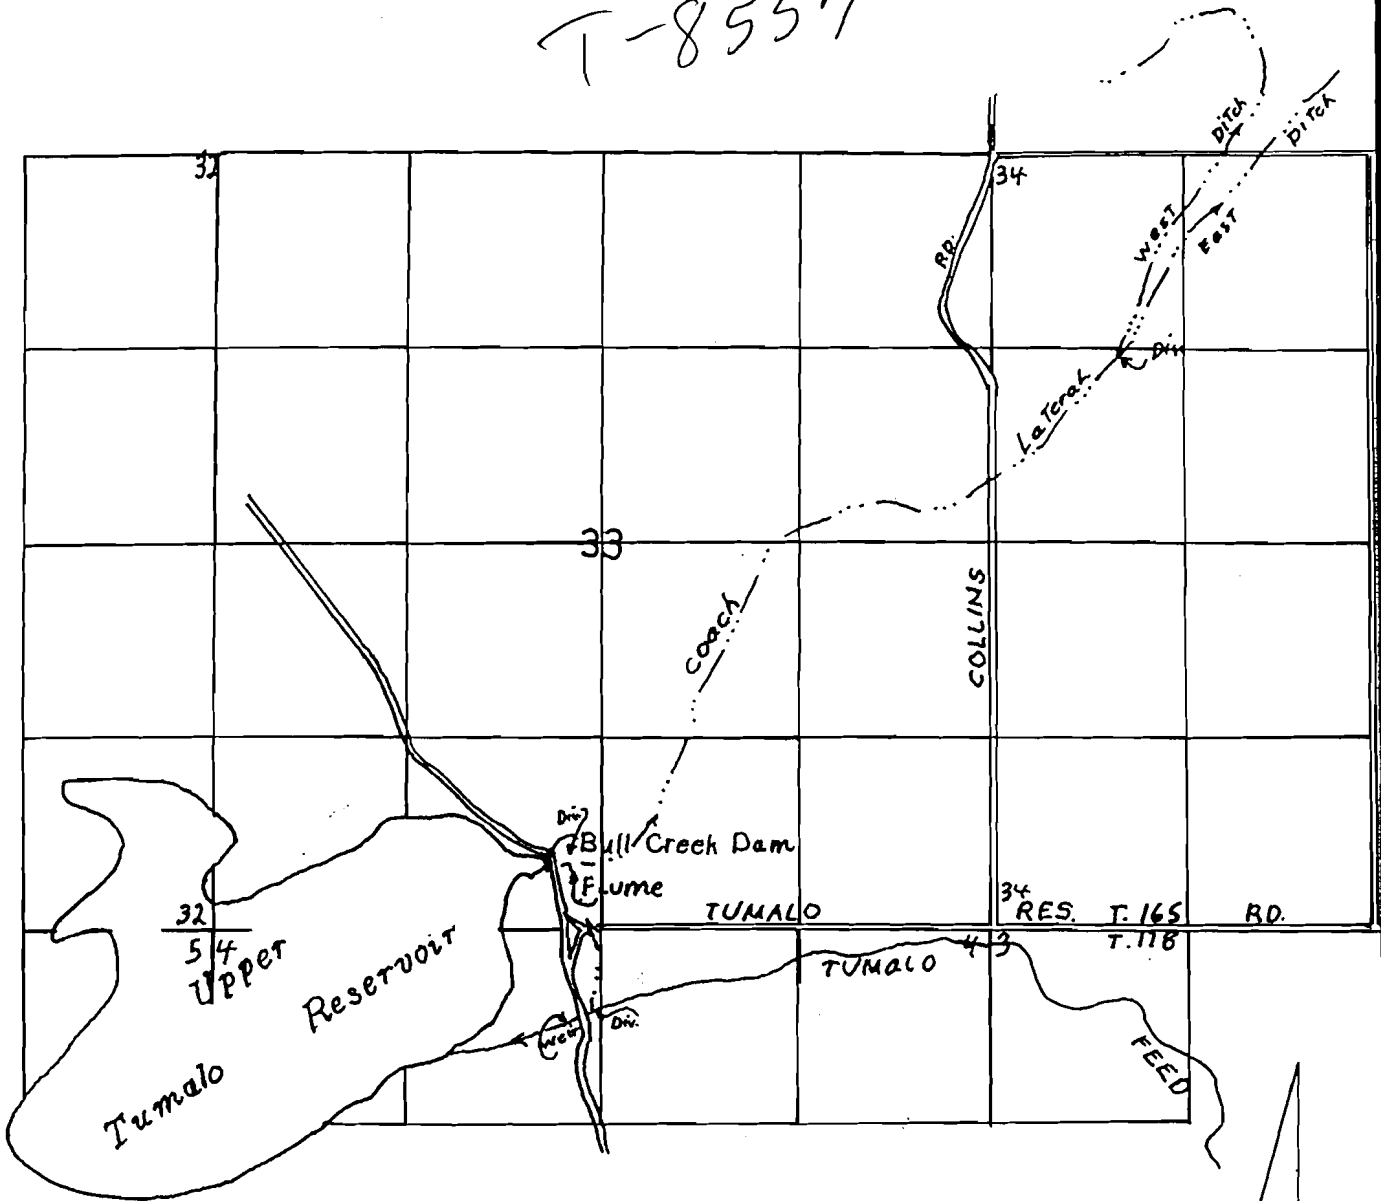

FINAL PROOF SURVEY UNDER

Application No. R-37238 Permit No. R-2743
IN NAME OF

...TUMALO IRRIGATION DISTRICT.

Surveyed AUG.26. 1998., by R.M.SUTTERFIELD WATER RESOURCES DEPT.
SALEM, OREGON

RECEIVED

JUN 27 2000

DIV. PT. 2080'S & 1310' W FROM
NE COR. OF SEC. 23.

7 1/2 quad - Tumalo Dam

Date 9-16-98

by R.M.S.