


TRANSFER APPLICATION MAP FOR CERTIFICATE # 13862
T. 40 S., R. 8 W., W. M., JOSEPHINE COUNTY
October 15, 2001

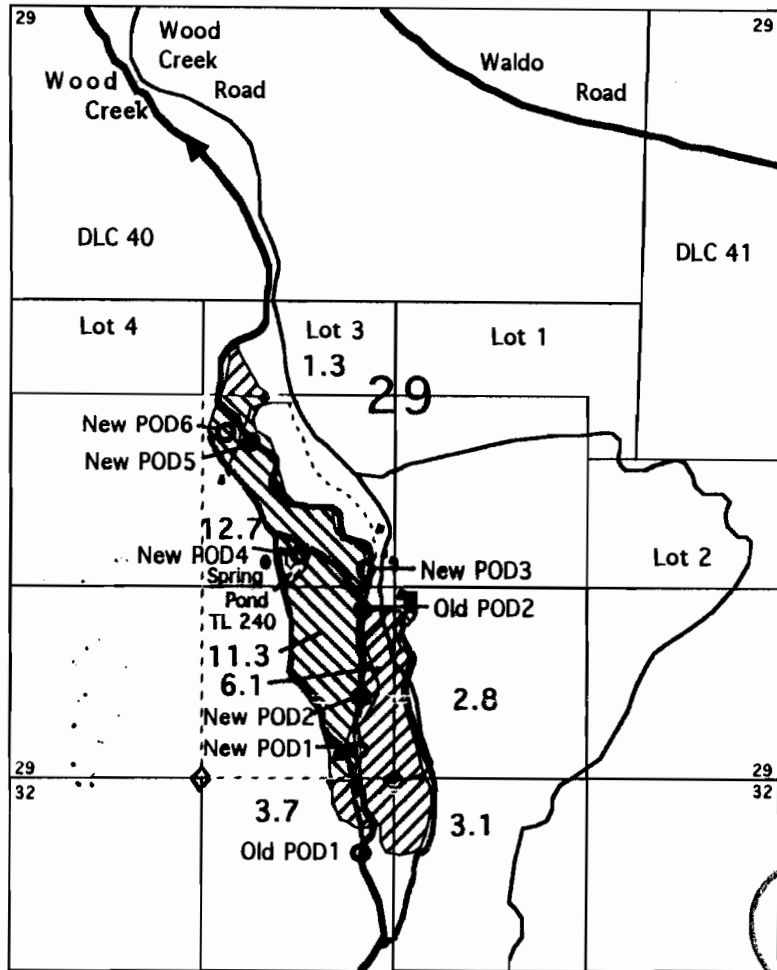

N
 ↑
 1" = 1320'

- Proposed Change in Point of Diversion from Certificate 13862
- Remaining Rights from Certificate 13862.

- New POD1 is 240' West and 200' North of the S1/4 Corner of Section 29.
- New POD2 is 220' West and 570' North of the S1/4 Corner of Section 29.
- New POD3 is 200' West and 1450' North of the S1/4 Corner of Section 29.
- New POD4 is 660' West and 1560' North of the S1/4 Corner of Section 29.
- New POD5 is 990' West and 2320' North of the S1/4 Corner of Section 29.
- New POD6 is 1160' West and 2390' North of the S1/4 Corner of Section 29.
- Old POD1 is 230' West and 500' South of the N1/4 Corner of Section 32.
- Old POD2 is 220' West and 1190' North of the S1/4 Corner of Section 29.

Gordon R. Lyford
 January 19, 1993
 STATE OF OREGON
 EXP. 12-31-2006
 10-15-2001

RECEIVED
 FEB 28 2005
 WATER RESOURCES DEPT
 SALEM, OREGON

This map was drawn by Gordon R. Lyford for Richard B. Jr. and Kathy H. Ethier to support their Water Right Transfer Application to change the authorized Point of Diversion from Wood Creek, via the Adams Ditches, to Wood Creek on their property via pumps. The Ethiers owns tax lot 240.

This map was prepared for the purposes of identifying the location of water rights only and is not intended to provide legal dimensions or the location of property ownership lines.

T-9874