


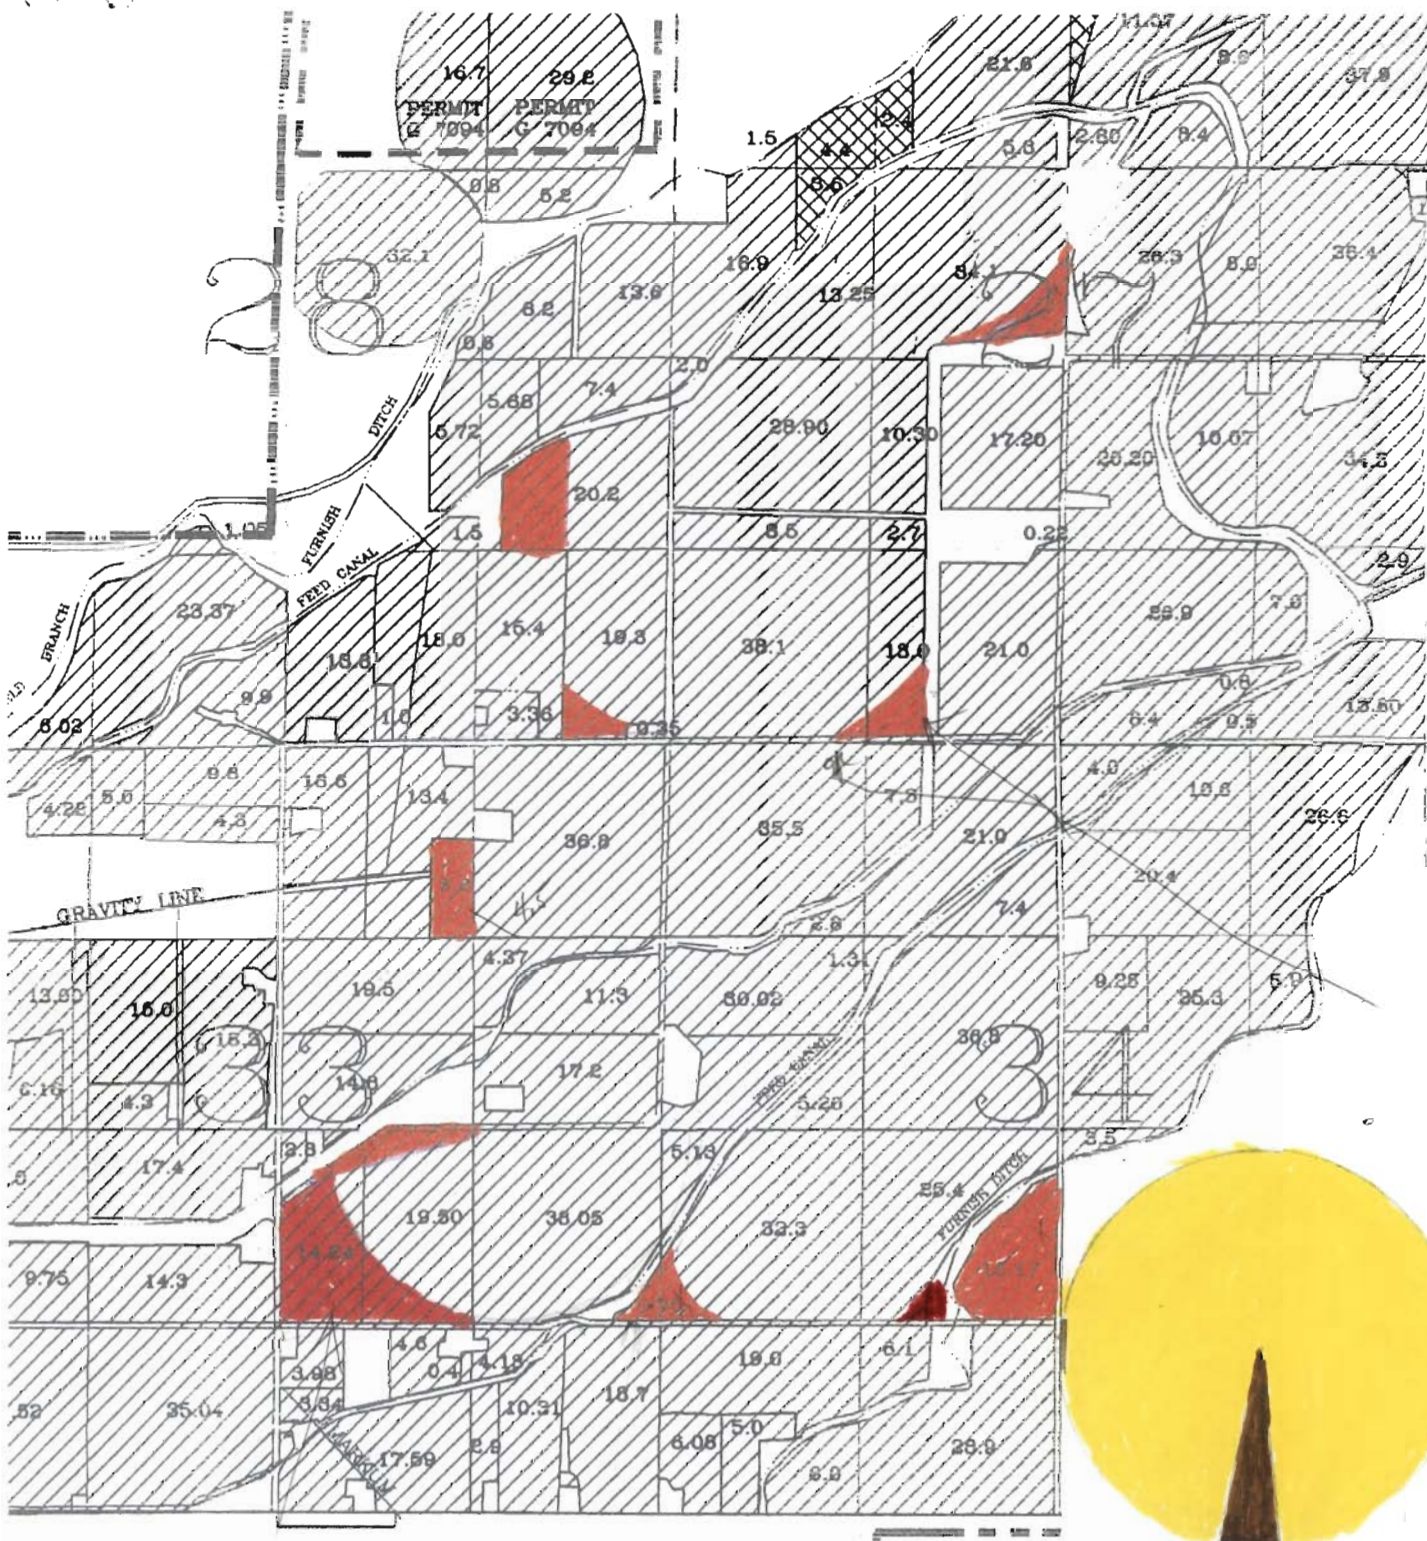

Alternate Acreage Map


Township 4 North Range 29 East W. M.

From 1905

From 1965

To 1905

To 1965

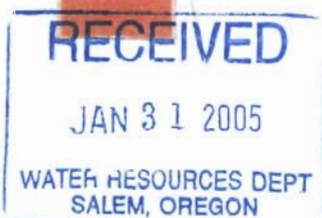


1" = 1,320' map

J-9867

3 NORTH

MATCH LINE DRAWING

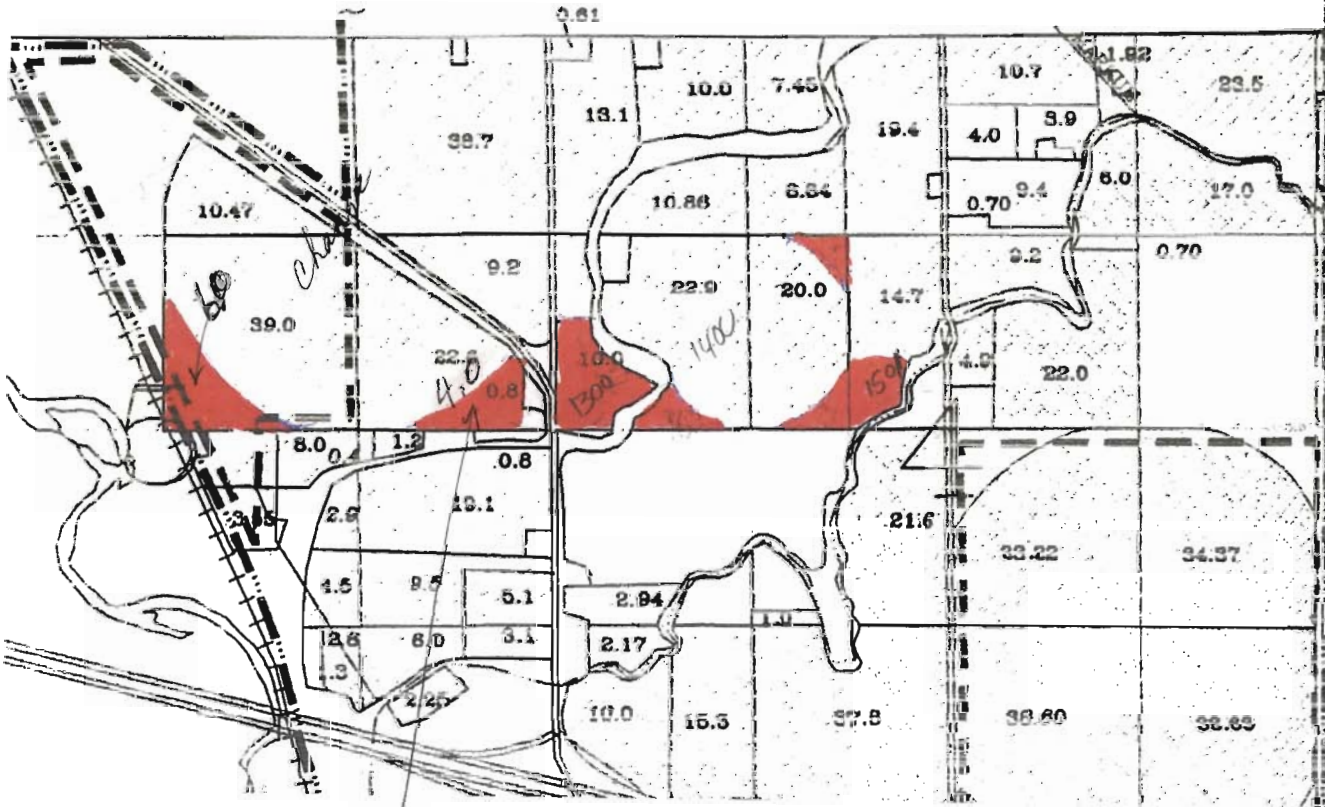

Alternate Acreage Map

Township 3 North Range 29 Section 4

RECEIVED

JAN 31 2005

WATER RESOURCES DEPT
SALEM, OREGON




RECEIVED

FEB 16 2005



WATER RESOURCES DEPT
SALEM, OREGON

T-9867

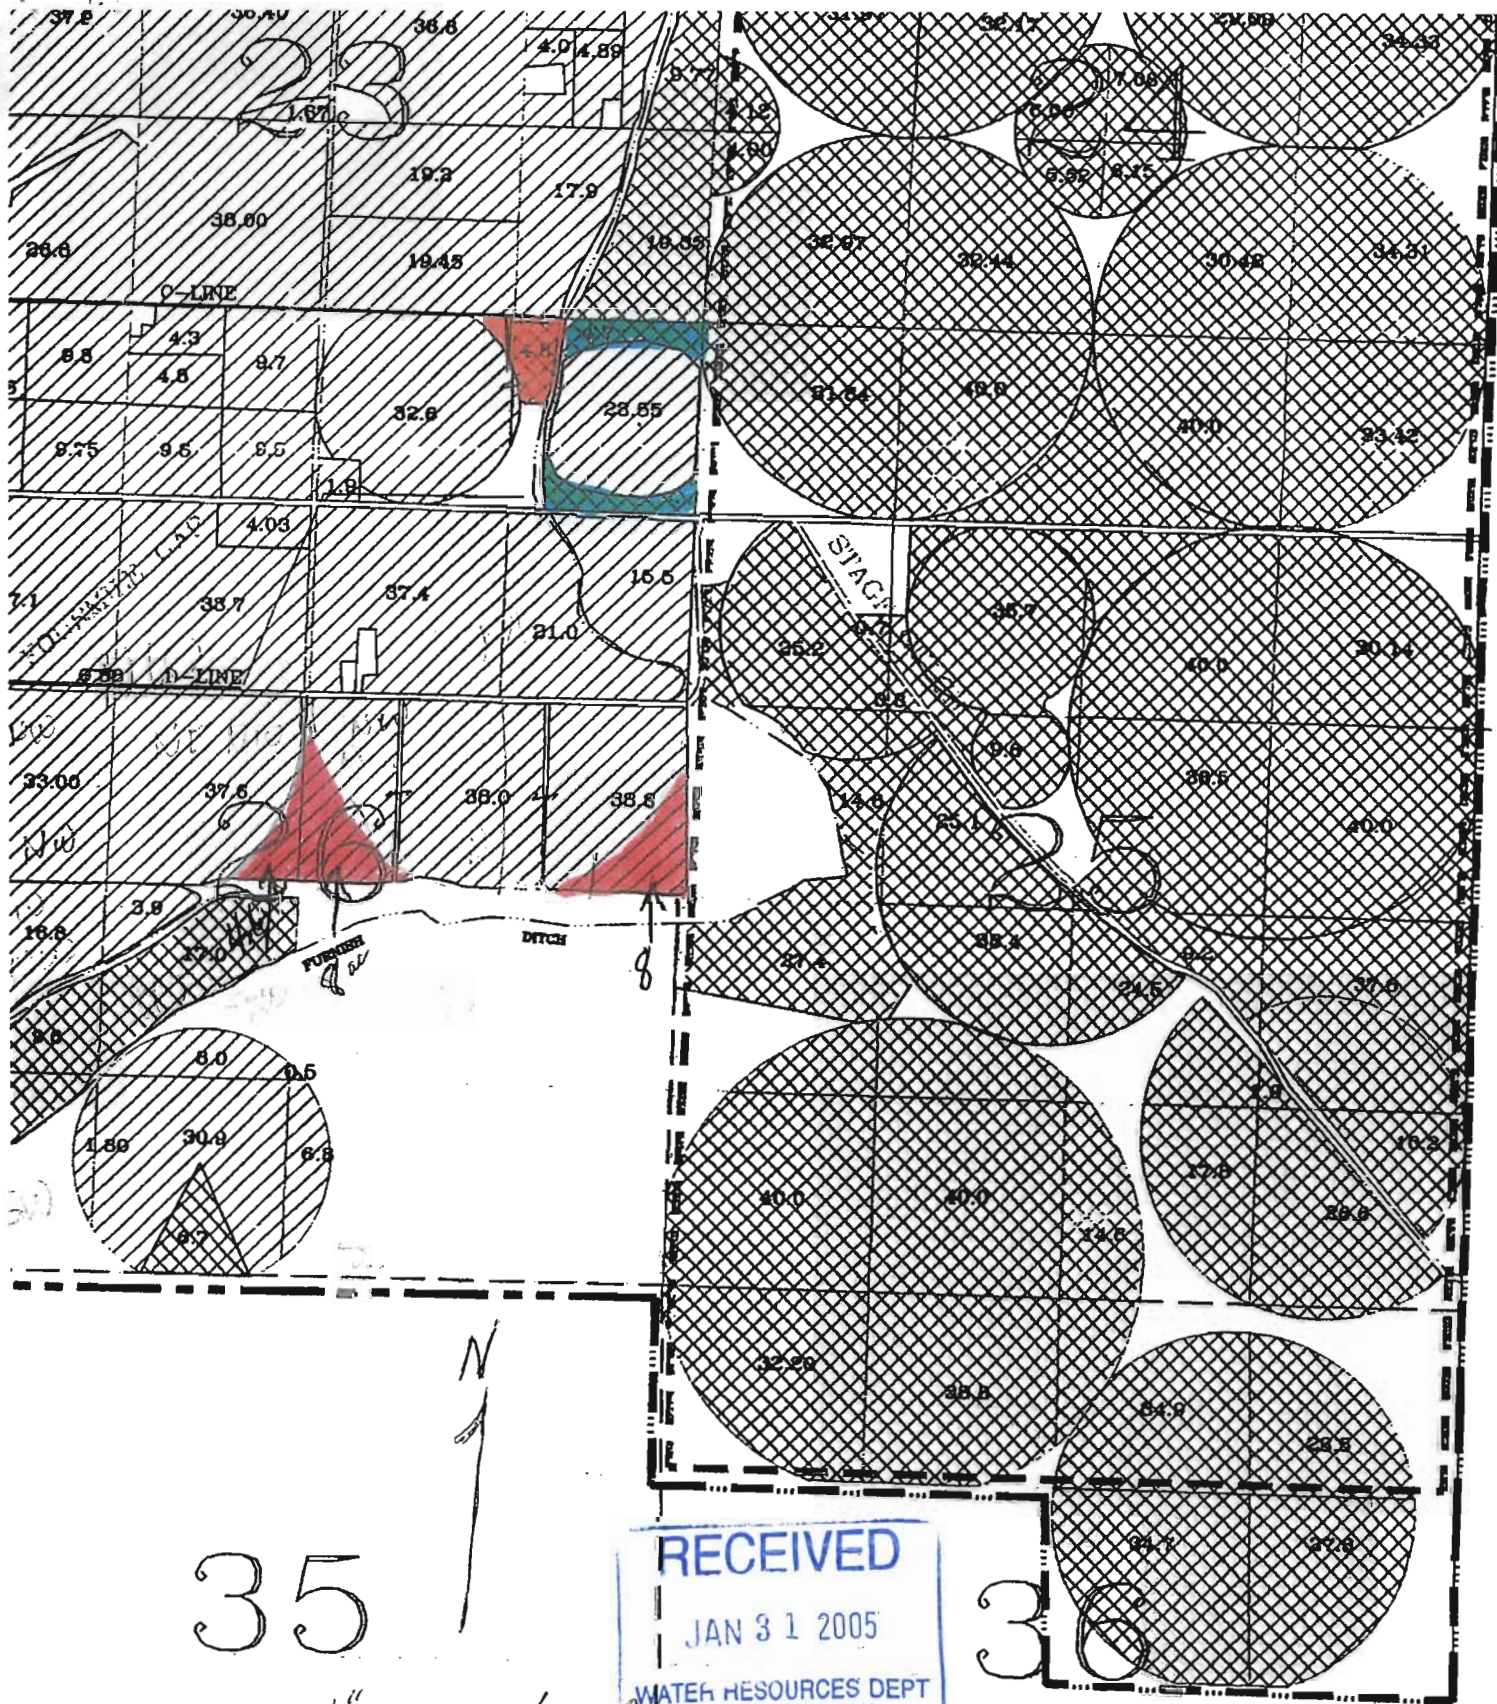

Alternate Acreage Map

Township 4 North Range 29 East W. M.

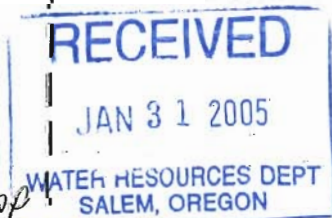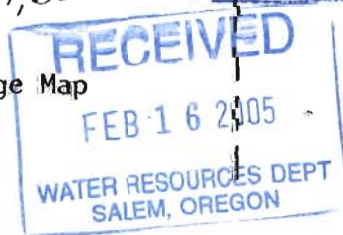

T-9867