


T. 3N.,
R. 29E.,
W.M.

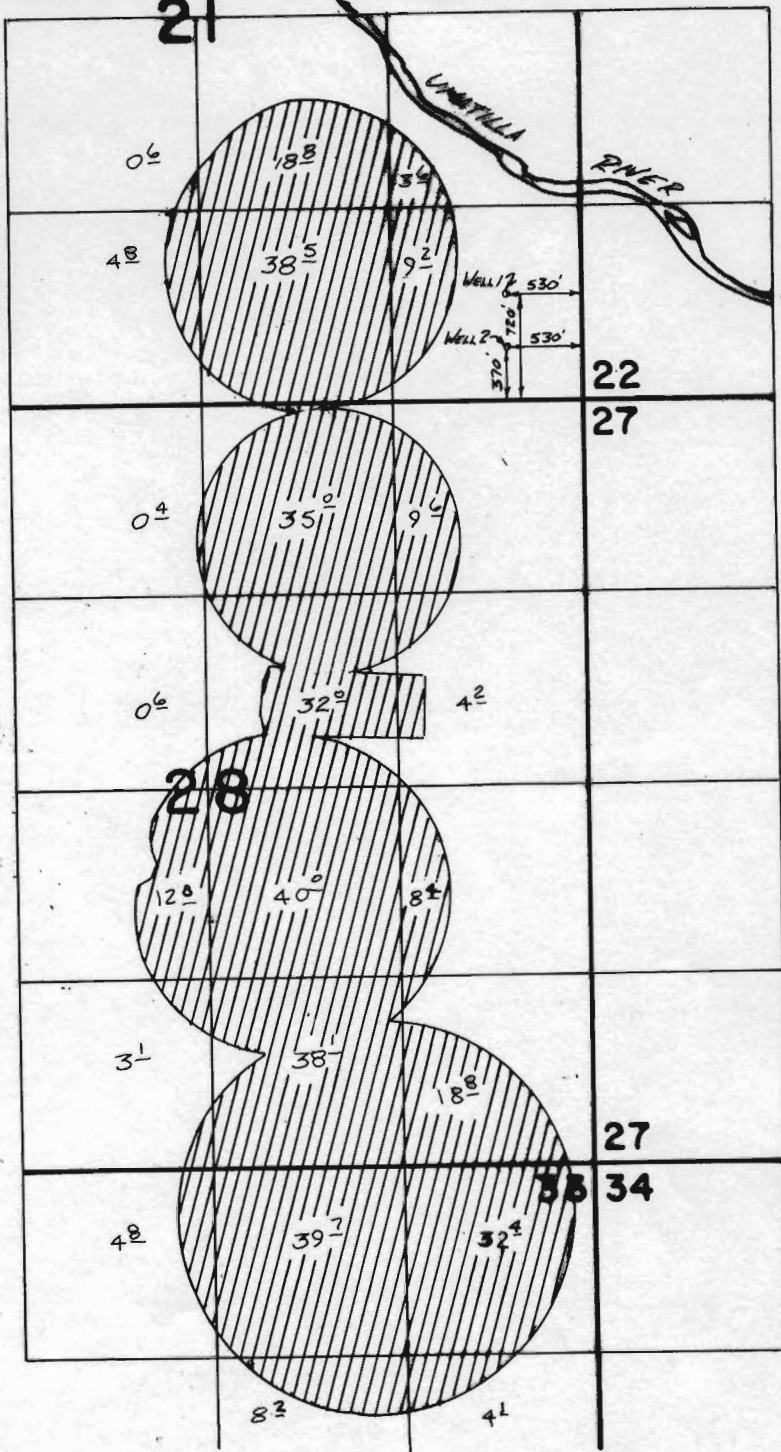

SCALE 1" = 1320'

**FINAL PROOF SURVEY
UNDER**

Application No. G-8976 Permit No. G-8369
IN NAME OF

RON HOLEMAN

Surveyed 7-28..... 1982, by V.H. Church