



# T.7S., R.1 & 2W., W.M.

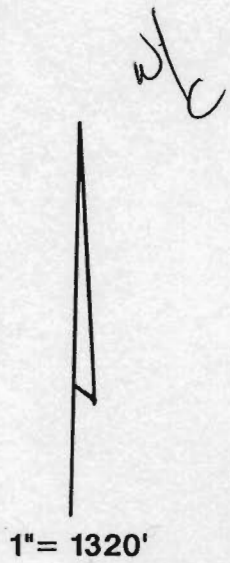

Well located 1460'N & 1270'W from NE corner DLC 56.

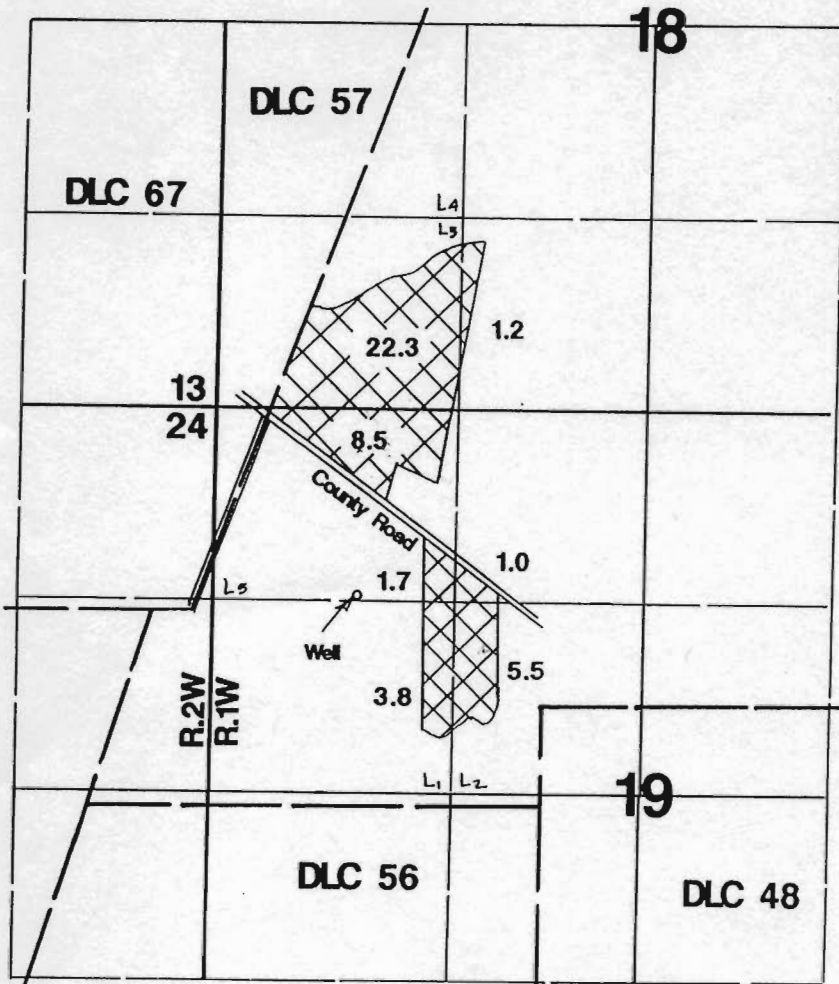

## Application Map

### Donald W. Mantie

Application #: G-12845 Permit #: G12006

THIS MAP WAS PREPARED FOR THE PURPOSE OF IDENTIFYING THE LOCATION OF A WATER RIGHT ONLY AND IS NOT INTENDED TO PROVIDE LEGAL DIMENSIONS OR LOCATION OF PROPERTY OWNERSHIP LINES.