


T.3N.R27E.W.M.

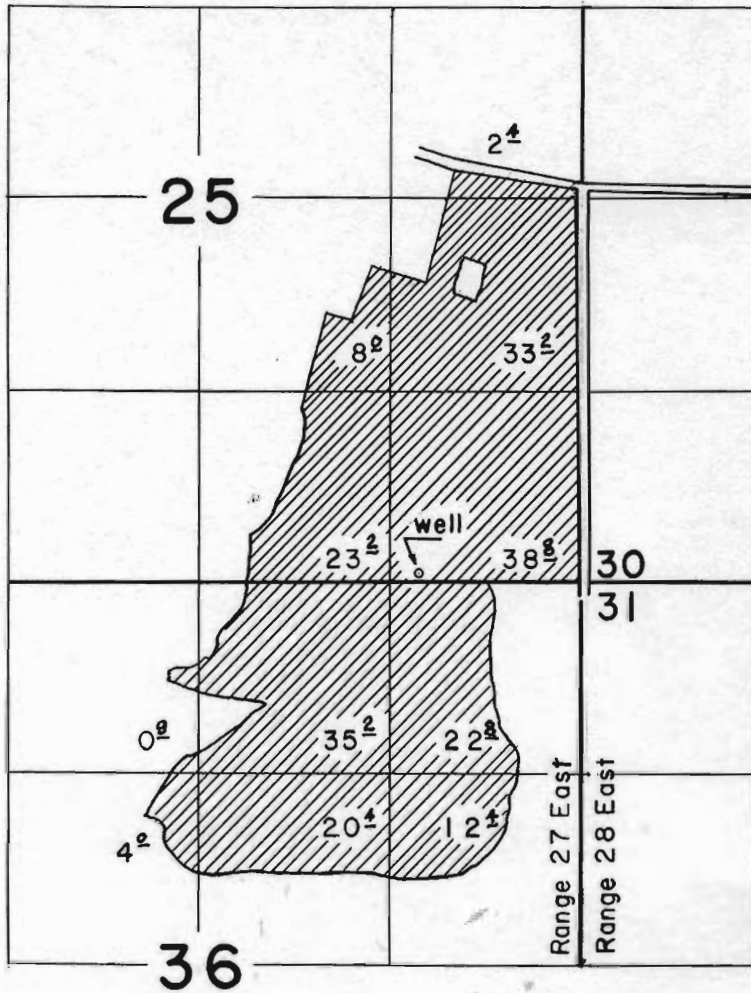

FINAL PROOF SURVEY  
UNDER

Application No. G-1845.. Permit No. G-1688..  
IN NAME OF

.....George B. Wallace.....

Surveyed Aug. 22.. 1964, by C. J. Gardner..