


T.6S.,R.4W.,W.M.

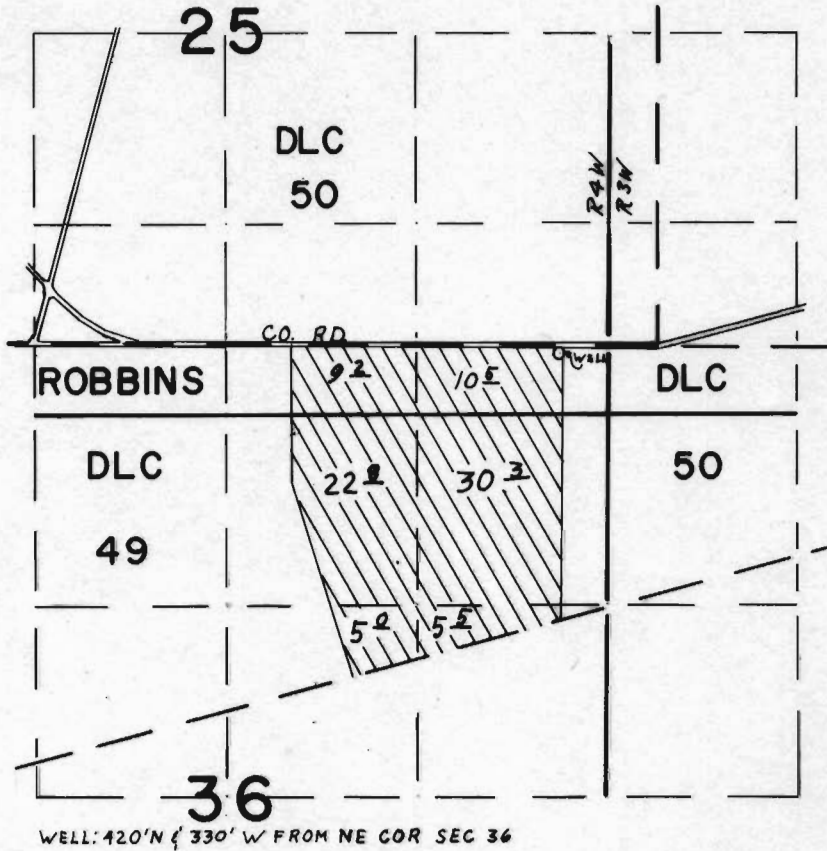

FINAL PROOF SURVEY
UNDER

Application No. G-5958 Permit No. G-5655
IN NAME OF

GORDON WALKER

Surveyed MAY 21 1976., by C.R. KING