


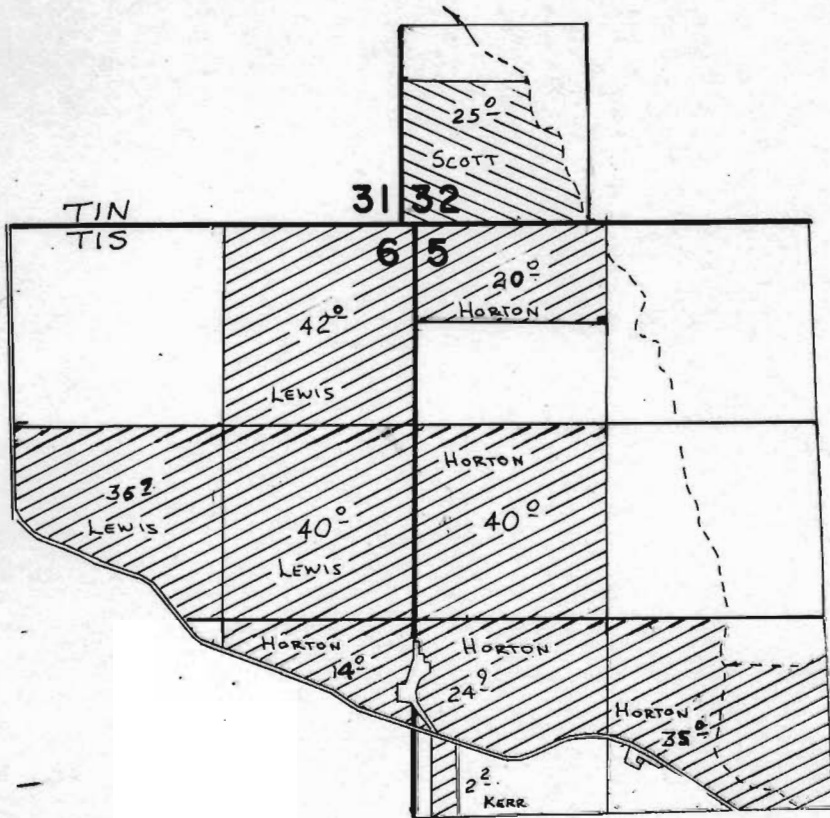


T.1N.8IS., R.43E., W.M.



-  PRIMARY
-  SUPPLEMENTAL



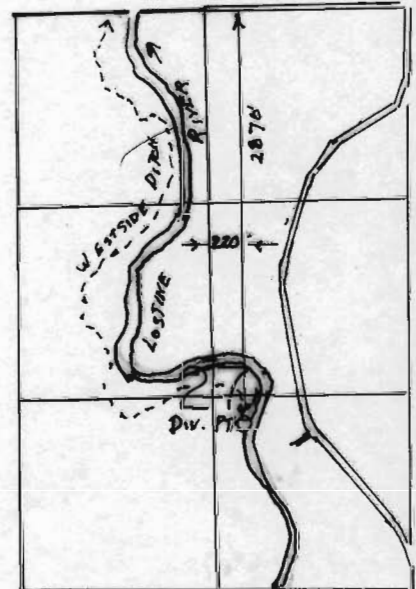FINAL PROOF SURVEY
UNDER

Application No. **50421**... Permit No. **38052**.
IN NAME OF

ALLEN CANYON SPRINKLER ASSOC.

Surveyed 8-12 1932, by V.L. Church