


T.18S. R.45E. W.M.

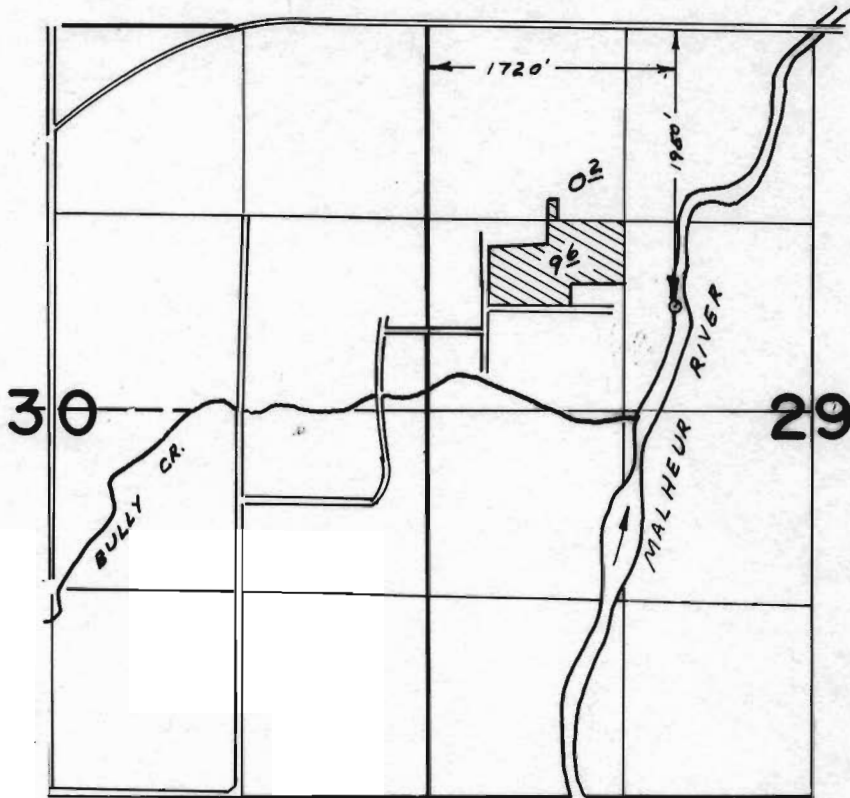

FINAL PROOF SURVEY
UNDER

Application No. 49877... Permit No. 37510...
IN NAME OF

VALE ELEMENTARY SCHOOL DIST. NO.15

Surveyed JUN. 27. 1978. by L.H. NUNN.....