


UMBERGER

T. 15 S., R. 14 E., W.M.

DRAFT B

"OFF MAP"

5⁰⁰
Acres →

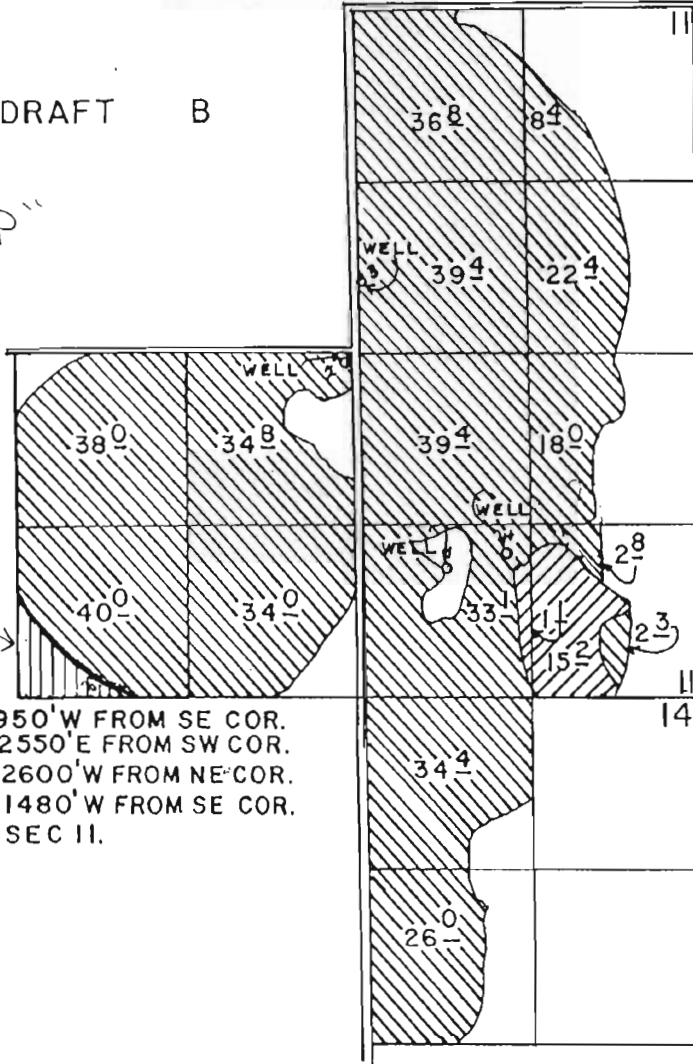

WELL 1, LOC: 980' N & 1950' W FROM SE COR.
 WELL 2, LOC: 2550' N & 2550' E FROM SW COR.
 WELL 3, LOC: 2060' S & 2600' W FROM NE COR.
 WELL 4, LOC: 1090' N & 1480' W FROM SE COR.
 ALL IN SEC 11.

- OFF Lands

RECEIVED

MAY 19 2005

WATER RESOURCES DEPT
SALEM, OREGON

SCALE: 1" = 1320'

PRIORITY DATE
DEC. 11, 1978

FINAL PROOF SURVEY

UNDER

Application No. G-9049 Permit No. G-8720
IN NAME OF



PRIMARY



SUPPLEMENTAL

WAMPLER-WERTH FARMS

Surveyed SEPT 13, 1984, by L.G. OLSEN

T-9936

C-68756

PHOTO SURVEY 41018-160-220L & 219L

1/11/95

R.M.S.

T 10156

RECEIVED

APR 27 2006

WATER RESOURCES DEPT
SALEM, OREGON